


Survey Monument Record

CORNER NO. 94
SECTION 30
TOWN 4N
RANGE 1E

TYPE OF MONUMENT COUNTY MONUMENT

PLACED (7/8" x 24" IRON BAR W/CAP)

FIELD BOOK: 98-04
PAGE (3)

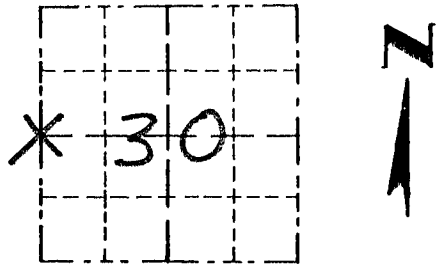

LOCATION
(Indicated by "X")

BASIS FOR MONUMENT LOCATION

(Use reverse side if necessary)

Show info such as: History of corner, with reference to Vol. and pg, dates, surveyor; exact description of monument replaced; if location computed, by taped or EDM traverse; landowner, remarks, etc.

SEAL:

CORNER SET IN 1832 BY SIBLEY. NO RECORD OF CORNER FOUND SINCE ORIGINAL SURVEY; CORNER WAS SET AT AN OCCUPIED FENCE CORNER. VERIFIED THIS LOCATION USING EDM METHODS.



CERTIFIED CORRECT

Larry L. Austin
Registered Land Surveyor

DATE: 4/13/98

TIE SKETCH

Show at least three (3) ties and monument
LEGEND

⊕ Co. Monument Set

○ 1/2" x 15" IRON BAR

XX EXISTING FENCE

