


GRANT COUNTY

PAID MAR 13 1996

Survey Monument Record

CORNER NO. 17
SECTION 3
TOWN 4N
RANGE 2W
W 1/4 COR

TYPE OF MONUMENT COUNTY MONUMENT
STATE PLANE COORDINATES: N _____
E _____
ELEVATION — M.S.L. DATUM: _____
THETA ANGLE: _____
FIELD BOOK: _____
PAGE _____

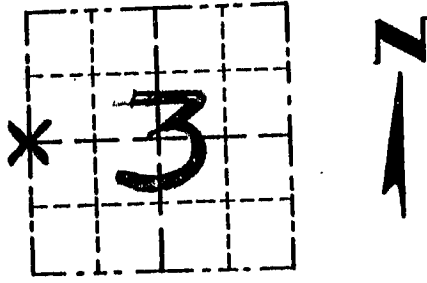

LOCATION
(Indicated by "X")


BASIS FOR MONUMENT LOCATION

(Use reverse side if necessary)

Show info such as: History of corner, with reference to Vol. and pg., dates, surveyor; exact description of monument replaced; if location computed, by taped or EDM traverse; landowner, remarks, etc.

SEAL:

ORIGINAL CORNER SET IN 1833.
BY ROBERT CLARK; NO
RECORD OF CORNER FOUND
SINCE THE ORIG. SURVEYS;
I SET THE CORNER AT
OCCUPIED LOCATION & VERIFIED
THE LOCATION BY EDM TRAVERSE
OF THE AREA.

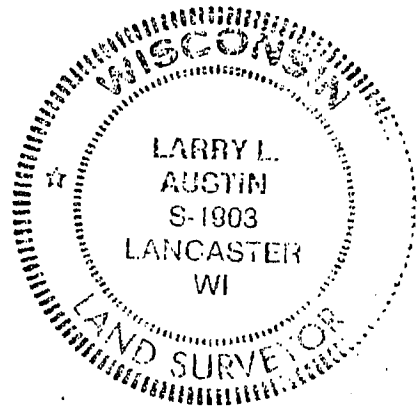

CERTIFIED CORRECT

Larry L. Austin
Registered Land Surveyor

DATE: 2/16/95

TIE SKETCH

Show at least three (3) ties and monument

LEGEND

- GRANT COUNTY Alum. Mon.
- 1/2" REBAR TIE SET
- *-* EXISTING FENCE

