

GRANT COUNTY

Survey Monument Record


TYPE OF MONUMENT COUNTY MONUMENT
 STATE PLANE COORDINATES: N _____
 E _____
 ELEVATION — M.S.L. DATUM: _____
 THETA ANGLE: _____
 FIELD BOOK: 9505
 PAGE 26

CORNER NO. 29
 SECTION 5
 TOWN 4 N
 RANGE 2 W

BASIS FOR MONUMENT LOCATION


(Use reverse side if necessary)

CORNER SET AT
 PROJECTION OF FENCE
 FROM THE NORTH ~~LINE~~
 AN EAST-WEST FENCE
 LINE; VERIFIED BY
 EDM TRAVERSE OF THE
 AREA

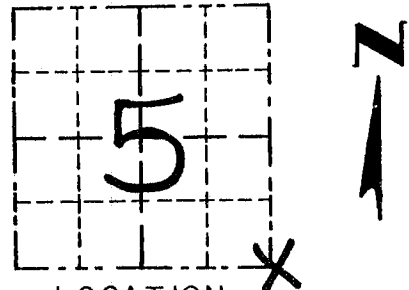

LOCATION
 (Indicated by "X")

SEAL:

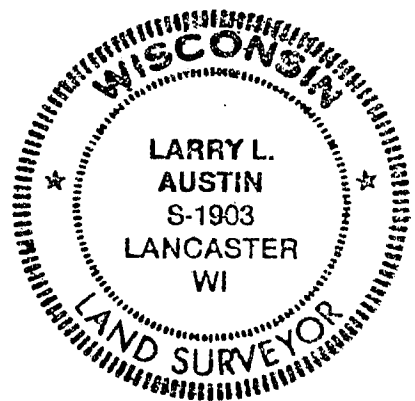

CERTIFIED CORRECT

Larry L. Austin
 Registered Land Surveyor

DATE: 12-5-95

TIE SKETCH

Show at least three (3) ties and monument

- LEGEND
- ⊕ GRANT COUNTY ALUMINUM MON. SET
 - △ 3/4" x 12" IRON BAR SET = TIES
 - X — EXISTING FENCE

