

GRANT COUNTY

Survey Monument Record


TYPE OF MONUMENT I-BEAM POST
 STATE PLANE COORDINATES: N _____
 E _____
 ELEVATION — M.S.L. DATUM: _____
 THETA ANGLE: _____
 FIELD BOOK: 9505
 PAGE: 24

CORNER NO. 30
 SECTION 5
 TOWN 4 N
 RANGE 2 W
S 1/4 COR.

BASIS FOR MONUMENT LOCATION

(Use reverse side if necessary)

Show info such as: History of corner, with reference to Vol. and pg., dates, surveyor; exact description of monument replaced; if location computed, by taped or EDM traverse; landowner, remarks, etc.

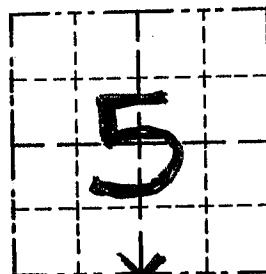


LOCATION
(Indicated by "X")



SEAL:

AN I-BEAM CORNER POST WAS ACCEPTED AT THE OCCUPATIONAL FENCE CORNER AND VERIFIED BY EDM TRAVERSE OF THE AREA

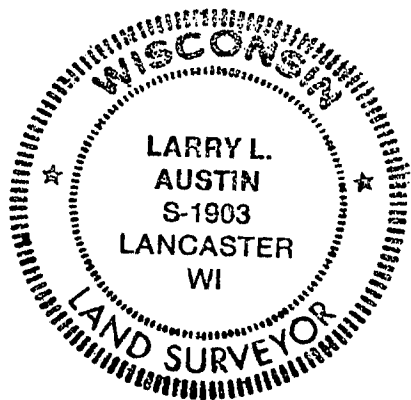

CERTIFIED CORRECT

Larry L. Austin
 Registered Land Surveyor


DATE: 12-5-95

TIE SKETCH

Show at least three (3) ties and monument

LEGEND

- I = I-BEAM CORNER POST
- o = 1" x 12" MIN. IRON PIPE SET = TIES
- * * * * * EXISTING FENCE

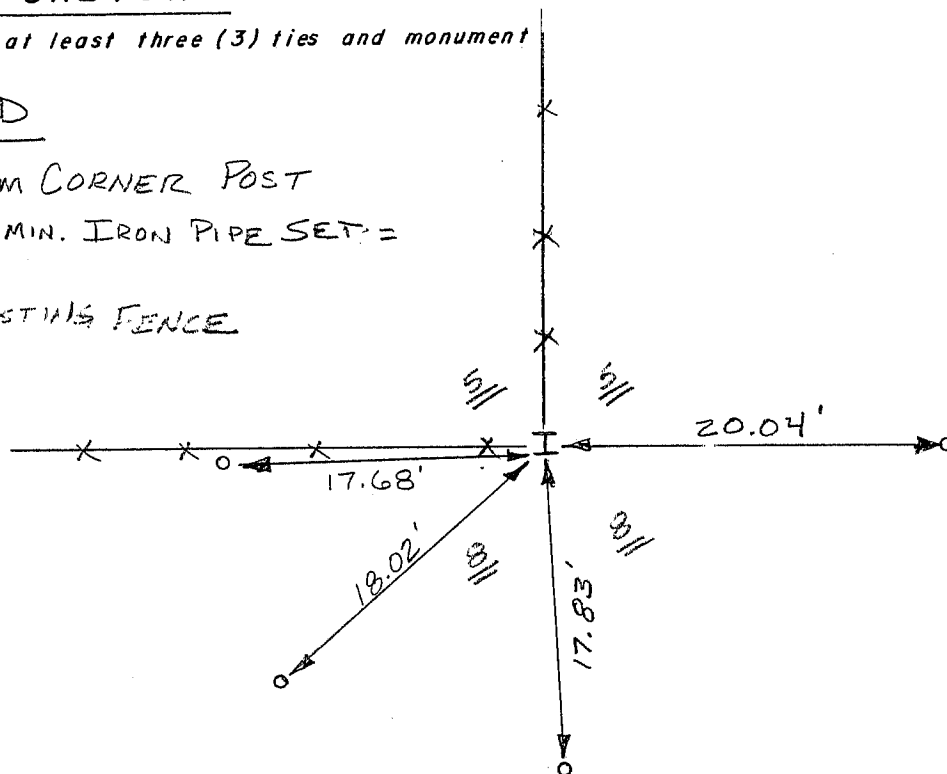

NO SCALE