


GRANT COUNTY

Survey Monument Record

TYPE OF MONUMENT ALUMINUM MONUMENT
 STATE PLANE COORDINATES: N _____
 E _____
 ELEVATION — M.S.L. DATUM: _____
 THETA ANGLE: _____
 FIELD BOOK: 95-05
 PAGE 24

CORNER NO. 16
 SECTION 5
 TOWN 4N
 RANGE 2W
 E 1/4 COR

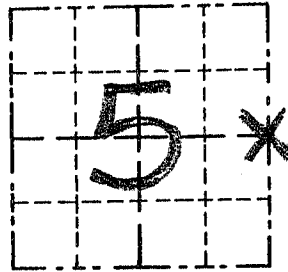

LOCATION
(Indicated by "X")


BASIS FOR MONUMENT LOCATION

(Use reverse side if necessary)

Show info such as: History of corner, with reference to Vol. and pg., dates, surveyor; exact description of monument replaced; if location computed, by taped or EDM traverse; landowner, remarks, etc.

SEAL:

FOR E-W. LOCATION OF CORNER
 I ACCEPTED A FOUND EVIDENCE
 LOCATION — EXISTING N-S FENCE;
 THE N-S LOCATION WAS SET
 AT RECORDED DISTANCE FROM
 NE CORNER OF THE SECTION
 THIS LOCATION FITS OTHER OCCUPATION
 IN THE AREA; VERIFIED BY
 EDM TRAVERSE OF THE
 AREA.

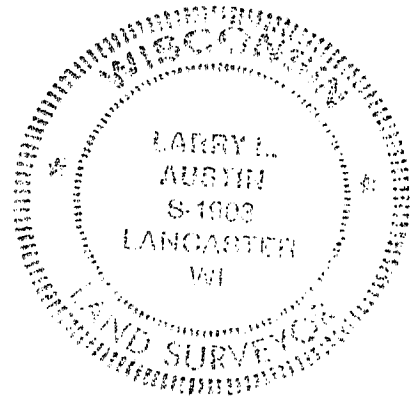

CERTIFIED CORRECT

Larry L. Austin
 Registered Land Surveyor

DATE: 12/6/95

TIE SKETCH

Show at least three (3) ties and monument

LEGEND

⊕ GRANT COUNTY ALUMINUM
 MONUMENT SET

○ 1" x 1/2" MIN. LENGTH
 IRON PIPES SET — TIES

— X — X — EXISTING
 FENCE

