

# GRANT COUNTY

## Survey Monument Record

TYPE OF MONUMENT COUNTY ALUMINUM MON.

STATE PLANE COORDINATES: N \_\_\_\_\_  
E \_\_\_\_\_

ELEVATION — M.S.L. DATUM: \_\_\_\_\_

THETA ANGLE: \_\_\_\_\_


FIELD BOOK: 9505

PAGE 24

CORNER NO. 31  
SECTION 5  
TOWN 4N  
RANGE 2W


### BASIS FOR MONUMENT LOCATION

(Use reverse side if necessary)

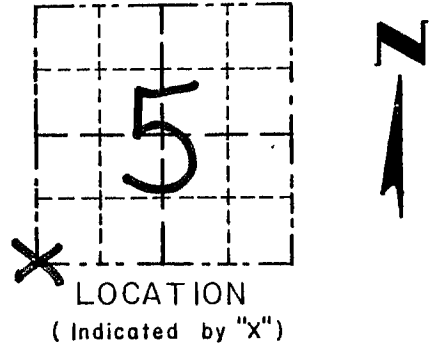

AN EAST-WEST FENCE WAS USED FOR THE NORTH-SOUTH LOCATION AND DOUBLED 40 OVER FROM THE EAST TO SET THE EAST-WEST LOCATION AND VERIFIED BY EDM TRAVERSE OF THE AREA.

SEAL:

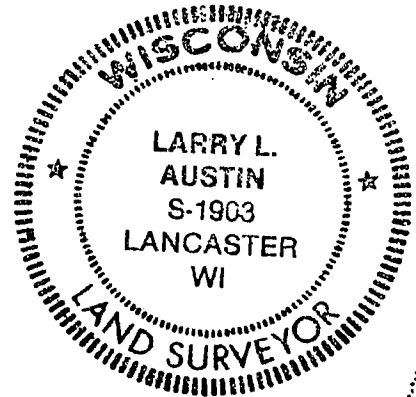

CERTIFIED CORRECT

*Larry L. Austin*  
Registered Land Surveyor

DATE: 12/5/95

### TIE SKETCH

Show at least three (3) ties and monument

### LEGEND

- ⊕ COUNTY ALUMINUM MONUMENT SET
- 1" x 12" IRON PIPES SET = TIES
- x — x — EXISTING FENCE

