

GRANT COUNTY

Survey Monument Record

TYPE OF MONUMENT GRANT COUNTY Alum. Mon

STATE PLANE COORDINATES: N _____
E _____


ELEVATION — M.S.L. DATUM: _____

THETA ANGLE: _____

FIELD BOOK: 95-14

PAGE 16

CORNER NO. 64
SECTION 14
TOWN 4N
RANGE 2W
S 1/4 Cor.

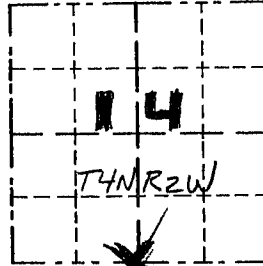

LOCATION
(Indicated by "X")


BASIS FOR MONUMENT LOCATION

(Use reverse side if necessary)

Show info such as: History of corner, with reference to Vol. and pg., dates, surveyor; exact description of monument replaced; if location computed, by taped or EDM traverse; landowner, remarks, etc.

CORNER WAS ORIGINALLY SET BY HARVEY PARKE IN 1833. NO RECORD FOUND OF CORNER SINCE ORIGINAL SURVEY. MONUMENT WAS PLACED AT FENCE INTERSECTION AFTER VERIFICATION BY EDM TRAVERSE

SEAL:

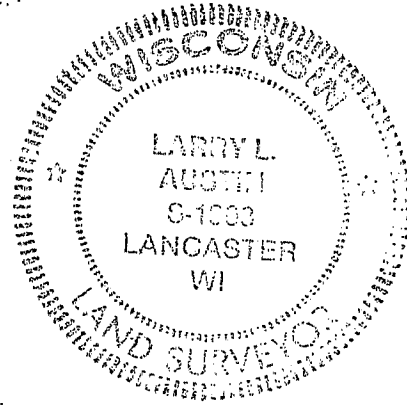

CERTIFIED CORRECT

Larry L. Aust
Registered Land Surveyor

DATE: 10/5/95

TIE SKETCH

Show at least three (3) ties and monument

