


GRANT COL NTY

Survey Monument Record

TYPE OF MONUMENT COUNTY MONUMENT
 STATE PLANE COORDINATES: N _____
 E _____
 ELEVATION — M.S.L. DATUM: _____
 THETA ANGLE: _____
 FIELD BOOK: 95-03
 PAGE 4

CORNER NO. 71
 SECTION 19
 TOWN 4 N
 RANGE 2 W
NECOR.

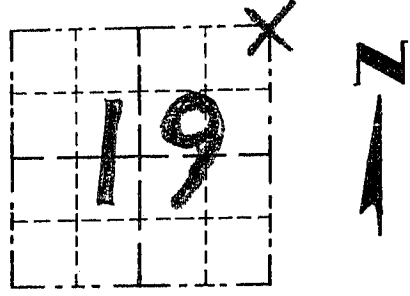

LOCATION
(Indicated by "X")


BASIS FOR MONUMENT LOCATION

(Use reverse side if necessary)

Show info such as: History of corner, with reference to Vol. and pg., dates, surveyor; exact description of monument replaced; if location computed, by taped or EDM traverse; landowner, remarks, etc.

ORIGINAL CORNER SET IN 1833 BY ROBERT CLARK.
 NO RECORD FOUND SINCE ORIGINAL SURVEY. CORNER WAS REESTABLISHED BASED ON OCCUPATIONAL EVIDENCE AND VERIFIED BY EDM TRAVERSE OF THE AREA.

SEAL:

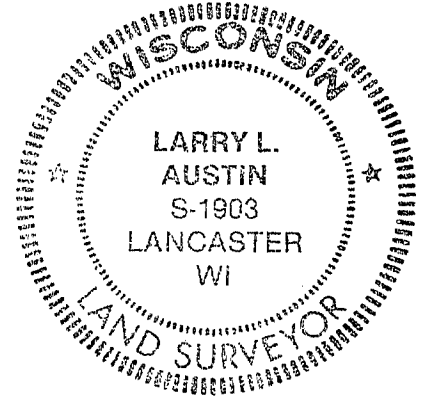

CERTIFIED CORRECT

Larry L. Austin
 Registered Land Surveyor

DATE: 2/28/95

TIE SKETCH

Show at least three (3) ties and monument

LEGEND

- ⊕ GRANT COUNTY ALUMINUM MONUMENT SET = CORNER
- 1" IRON PIPE SET = TIES
- *** EXISTING FENCE

