

GRANT COUNTY

Survey Monument Record

TYPE OF MONUMENT 3/4" X 24" IRON BAR SET

STATE PLANE COORDINATES: N _____
E _____


ELEVATION — M.S.L. DATUM: _____

THETA ANGLE: _____

FIELD BOOK: 96-14


PAGE: (26)

CORNER NO. 91
SECTION 30
TOWN 4N
RANGE 2W

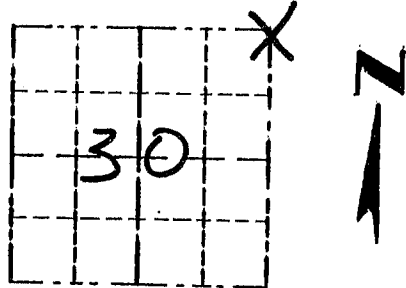

LOCATION
(Indicated by "X")

SEAL:

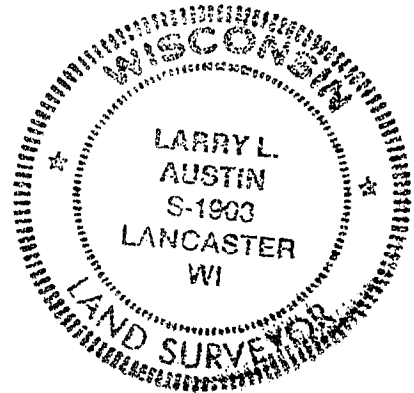

CORNER SET IN 1833
BY ROBERT CLARK,
IN 1996 DAVID BURBACH
SET A 3/8" X 12" SPIKE
AT A OCCUPIED CHANGE IN
E-W FENCE, I ACCEPTED
HIS LOCATION AFTER A
PHONE CONVERSATION I
HAD WITH HIM. VERIFIED
ITS LOCATION USING EDM
METHODS

CERTIFIED CORRECT

Larry L. Austin
Registered Land Surveyor

DATE: 1-25-97

TIE SKETCH

Show at least three (3) ties and monument

LEGEND

⊕ 3/4" X 24" IRON BAR SET

○ 1/2" X 15" IRON BAR SET

--- EXISTING FENCE Woods

