

GRANT COUNTY

Survey Monument Record

TYPE OF MONUMENT 3/4" IRON BAR SET

STATE PLANE COORDINATES: N _____
E _____


ELEVATION — M.S.L. DATUM: _____

THETA ANGLE: _____

FIELD BOOK: 96-14

PAGE (26)

CORNER NO. 92
SECTION 30
TOWN 4N
RANGE 2W

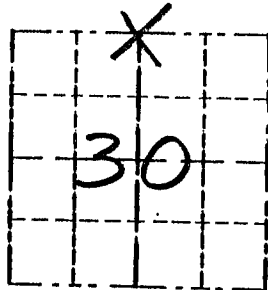


LOCATION
(Indicated by "X")

BASIS FOR MONUMENT LOCATION

(Use reverse side if necessary)

CORNER SET IN 1833
BY ROBERT CLARK, NO
RECORD OF CORNER FOUND
SINCE ORIGINAL SURVEYS;
CORNER WAS SET AT
A PROPORTIONED DISTANCE
FROM THE NE AND THE
NW CORNER OF SECTION
30, VERIFIED ITS LOCATION
USING EDM METHODS.

SEAL:

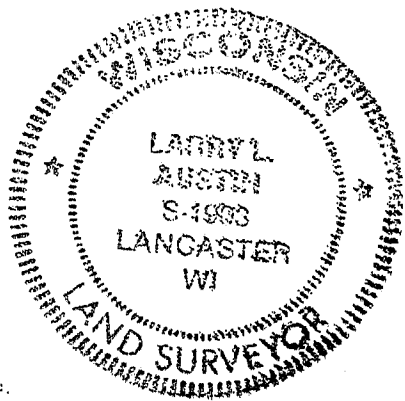

CERTIFIED CORRECT

Larry L. Austin
Registered Land Surveyor

DATE: 1-27-97

TIE SKETCH

Show at least three (3) ties and monument

