

Survey Monument Record

CORNER NO. \_\_\_\_\_  
SECTION 20  
TOWN 4N  
RANGE 2W

TYPE OF MONUMENT GRANT COUNTY Alum. Mon.


STATE PLANE COORDINATES: N \_\_\_\_\_  
E \_\_\_\_\_

ELEVATION — M.S.L. DATUM: \_\_\_\_\_

THETA ANGLE: \_\_\_\_\_

FIELD BOOK: 95-11

PAGE \_\_\_\_\_

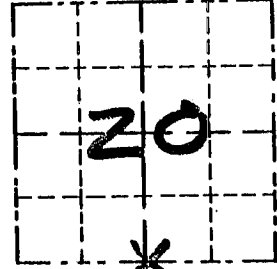


LOCATION  
(Indicated by "X")

BASIS FOR MONUMENT LOCATION

(Use reverse side if necessary)

ORIGINAL CORNER SET  
IN 1833 BY ROBERT  
CLARK; CORNER WAS  
RE-ESTABLISHED ON A  
SURVEY FOR KENNETH RICE  
BY DALE RICE IN 1979; I  
BRUCE BOWDEN RE-ESTABLISH  
THE CORNER IN 1986 ON A  
SURVEY FOR L. AUSTIN. THIS  
CORNER WAS RESET USING THE  
FOUND MONUMENTS FROM THE 1986  
BOWDEN SURVEY.

SEAL:

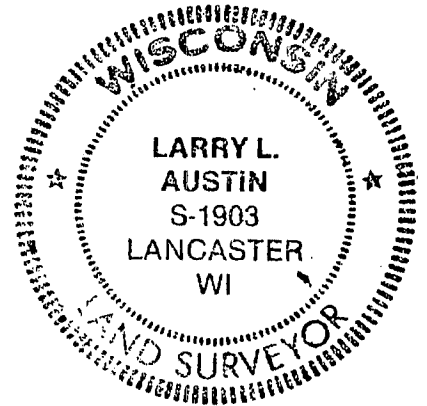

CERTIFIED CORRECT

*Larry L. Austin*  
Registered Land Surveyor

DATE: 12-15-95

TIE SKETCH

Show at least three (3) ties and monument

