


GRANT COUNTY

Survey Monument Record

CORNER NO. 106
 SECTION 34
 TOWN 4 N
 RANGE 2 W
N 1/4

TYPE OF MONUMENT 2" X 30" Rd. Iron Pipe
 STATE PLANE COORDINATES: N _____
 E _____
 ELEVATION — M.S.L. DATUM: _____
 THETA ANGLE: _____
 FIELD BOOK: 9402
 PAGE 5

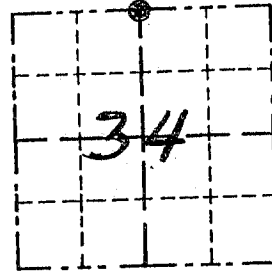

LOCATION
 (Indicated by "●")


BASIS FOR MONUMENT LOCATION

(Use reverse side if necessary)

Show info such as: History of corner, with reference to Vol. and pg., dates, surveyor; exact description of monument replaced; if location computed, by taped or EDM traverse; landowner, remarks, etc.

NO RECORD OF CORNER FD, SINCE DRIG. SURVEYS; ACCEPTED OCCUPATION FOR N-S LOCATION; SET E-W LOCATION EQUIDISTANT FROM NE CORNER & NW CORNER. FITS WELL WITH OLD FENCE REMNANTS IN THE AREA.

SEAL:

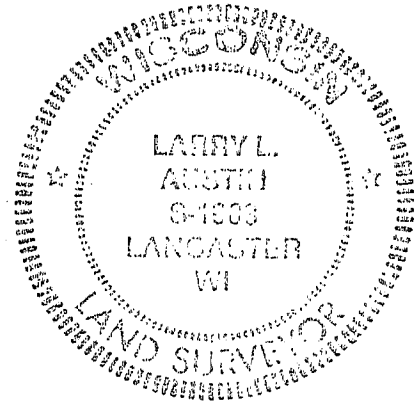

CERTIFIED CORRECT

Larry L. Austin
 Registered Land Surveyor

DATE: 2/24/94

TIE SKETCH

Show at least three (3) ties and monument

LEGEND

- ⊕ Alum. Mon. = CORNER
- 1/2" x 18" REBAR = TIES
- X — X — EXISTING FENCE

