

GRANT COUNTY

Survey Monument Record

TYPE OF MONUMENT COUNTY MONUMENT

STATE PLANE COORDINATES: N _____
E _____


ELEVATION — M.S.L. DATUM: _____

THETA ANGLE: _____

FIELD BOOK: 95 11

PAGE _____

CORNER NO. 111
SECTION 30
TOWN 4 N
RANGE 2 W

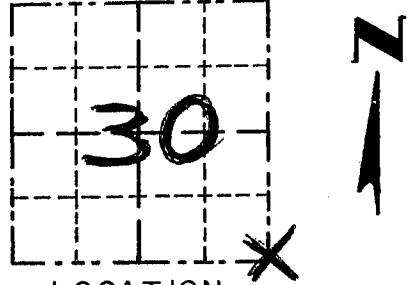

LOCATION
(Indicated by "X")


BASIS FOR MONUMENT LOCATION

(Use reverse side if necessary)

Show info such as: History of corner, with reference to Vol. and pg., dates, surveyor; exact description of monument replaced; if location computed, by taped or EDM traverse; landowner, remarks, etc.

SEAL:

ORIGINAL CORNER SET
IN 1833 BY ROBERT
CLARK
ALUMINUM MONUMENT SET
AT THE OCCUPIED FENCE
CORNER AND VERIFIED BY
EDM TRAVERSE OF THE
AREA

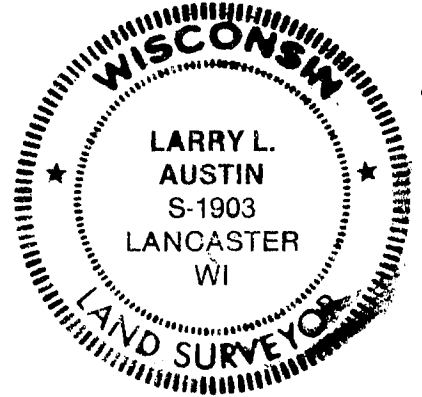

CERTIFIED CORRECT

Larry L. Austin
Registered Land Surveyor

DATE: 11/1/95

TIE SKETCH

Show at least three (3) ties and monument

LEGEND

- ⊕ GRANT Co. ALUMINUM MONUMENT
- 1" x 12" IRON PIPE = TIES
- x — x — EXISTING FENCE

