

GRANT COUNTY CERTIFIED LAND CORNER

CORNER NUMBER 121

CERTIFICATE:


I, LARRY L. AUSTIN, DO HEREBY CERTIFY THAT ON THIRTEENTH DAY OF OCTOBER, 1999, I FOUND EVIDENCE OF THE SOUTHEAST CORNER OF SECTION 36, TOWN 4 NORTH, RANGE 2 WEST, OF THE FOURTH PRINCIPAL MERIDIAN, AND I RE-ESTABLISHED SAID CORNER ACCORDING TO THE WISCONSIN STATUTES AS SHOWN AND DESCRIBED HEREON.

DATED THIS FIFTEENTH DAY OF OCTOBER, 1999

Larry L. Austin
LARRY L. AUSTIN S-1903



SEAL

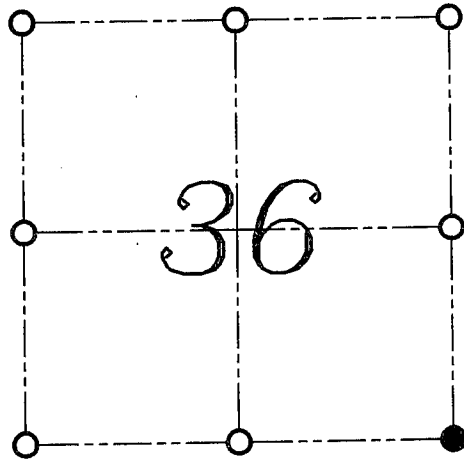

● = CORNER LOCATION

SOUTHEAST CORNER OF
SECTION 36, T 4 N R 2 W
TOWN OF ELLENBORO

HISTORY OF ORIGINAL CORNER ESTABLISHMENT:

Corner was originally set in 1832 by Sibley.
I set a 1" by 30" rebar in 1988.

DESCRIPTION OF CORNER EVIDENCE FOUND:

I found the corner set in 1988.
I accepted it's location after an E.D.M. and G.P.S.
traverse of the area.

DESCRIPTION OF CORNER AND WITNESS MONUMENTS, REFERENCES AND ACCESSORIES USED TO PERPETUATE THE ORIGINAL OR RE-ESTABLISHED LOCATION OF THIS CORNER:
WITNESS TO THE CORNER LOCATION: BOBBY SEDGWICK ; SHELBY BLINDERT

SKETCH:

