


Survey Monument Record

TYPE OF MONUMENT 3/4" X 24" IRON BAR SET

CORNER NO. 122
 SECTION 36
 TOWN 4N
 RANGE 2W

FIELD BOOK: 96-14
 PAGE 34

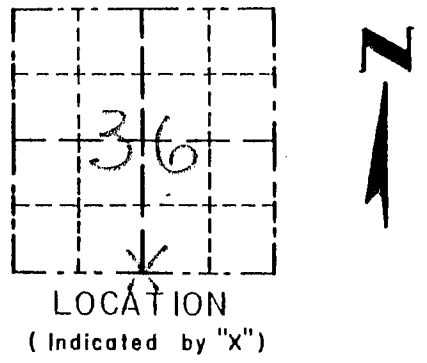


BASIS FOR MONUMENT LOCATION

(Use reverse side if necessary)
 Show info such as: History of corner, with reference to Vol. and pg., dates, surveyor; exact description of monument replaced; if location computed, by taped or EDM traverse; landowner, remarks, etc.

CORNER SET IN 1832 BY SIBLEY. NO RECORD OF CORNER FOUND SINCE ORIGINAL SURVEY; CORNER WAS SET AT 1/2 OF THE RECORDED OFFSET DISTANCE AT THE SW CORNER (30 LINKS) THIS LOCATION WAS VERIFIED EAST/WEST USING EDM METHODS.

SEAL:

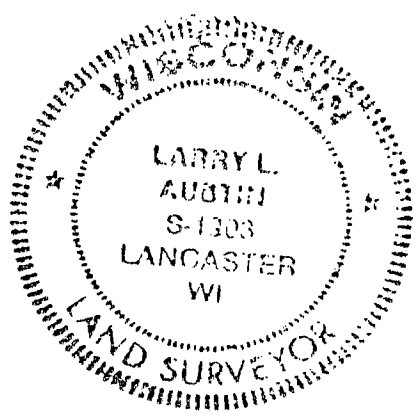


CERTIFIED CORRECT
Larry L. Austin
 Registered Land Surveyor
 DATE: 7/30/97

TIE SKETCH

Show at least three (3) ties and monument

LEGEND

- ⊙ 3/4" X 24" IRON BAR SET
- 1/2" X 15" IRON BAR SET
- ** EXISTING FENCE

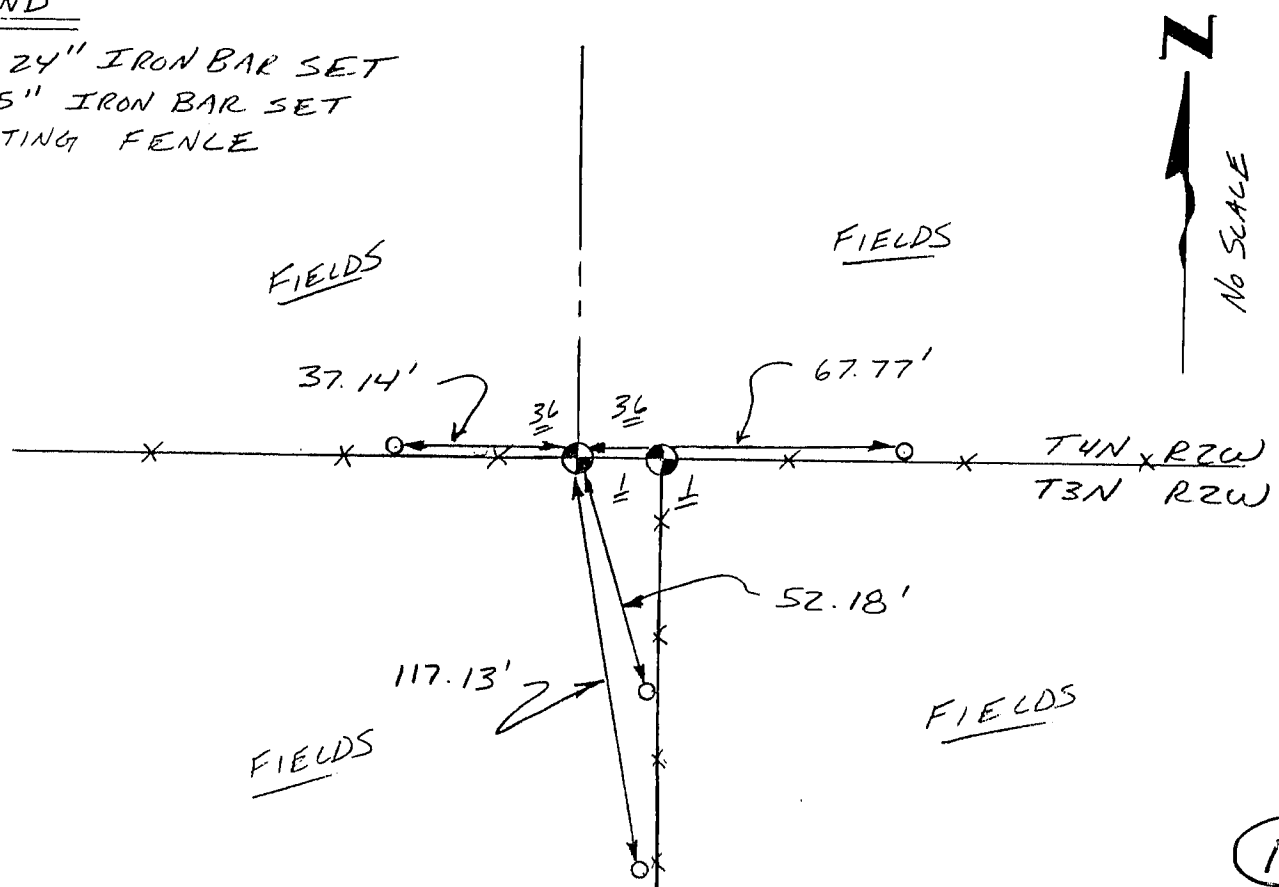


Survey Monument Record

TYPE OF MONUMENT 3/4" X 24" IRON BAR
SET

CORNER NO. 02
 SECTION 01
 TOWN 3N
 RANGE 2W

FIELD BOOK: 96.14
 PAGE 34

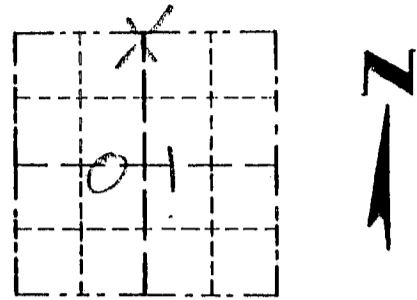

LOCATION
 (Indicated by "X")


BASIS FOR MONUMENT LOCATION

(Use reverse side if necessary)

Show info such as: History of corner, with reference to Vol. and pg. dates, surveyor; exact description of monument replaced; if location computed, by taped or EDM traverse; landowner, remarks, etc.

SEAL:

CORNER WAS NOT SET BY THE ORIGINAL SURVEYS. NO RECORD WAS FOUND SINCE ORIGINAL SURVEYS. CORNER WAS SET ONLINE WITH A NORTH/SOUTH FENCE FOR EASTING. CORNER WAS SET ONLINE WITH THE SW AND THE SE CORNER OF SECTION 36 T4N R2W. VERIFIED ITS LOCATION USING EDM METHODS.

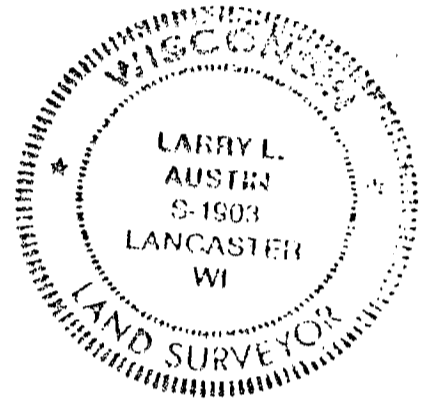

CERTIFIED CORRECT

Larry L. Austin
 Registered Land Surveyor

DATE: 7/30/97

TIE SKETCH

Show at least three (3) ties and monument

