

GRANT COUNTY


Survey Monument Record

TYPE OF MONUMENT 3/4" X 24" IRON BAR SET W/
 STATE PLANE COORDINATES: N _____ CAP. _____
 E _____
 ELEVATION — M.S.L. DATUM: _____
 THETA ANGLE: _____
 FIELD BOOK: 96-06
 PAGE _____

CORNER NO. 30
 SECTION 8
 TOWN 4N
 RANGE 3W


BASIS FOR MONUMENT LOCATION

(Use reverse side if necessary)

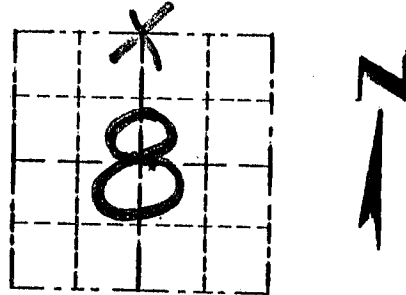

LOCATION
(Indicated by "X")

CORNER SET IN 1833 BY ROBERT CLARK. ORIGINAL BEARING TREES SEAL: WERE UNRECOVERABLE. NO RECORD OF COR. FOUND SINCE ORIGINAL SURVEYS. CORNER SET ONLINE WITH OCCUPIED 40 TO WEST AND THE NORTHWEST CORNER OF SECTION FOR NORTHING, FOR EASTING I ACCEPTED A NORTH/SOUTH FENCE. VERIFIED THIS LOCATION USING EDM METHODS.

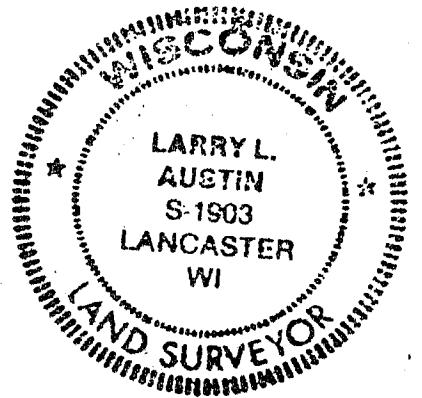

CERTIFIED CORRECT

Larry L. Austin
 Registered Land Surveyor

DATE: 9/30/96

TIE SKETCH

Show at least three (3) ties and monument.

FIELDS

PASTURE

PASTURE

LEGEND

- 3/4" X 24" IRON BAR SET W/ CAP.
- 1/2" X 18" IRON BAR SET
- X — X — EXISTING FENCE

