

GRANT COUNTY

Survey Monument Record

TYPE OF MONUMENT 3/4" x 24" IRON BAR SET W/ CAP

STATE PLANE COORDINATES: N _____
E _____


ELEVATION — M.S.L. DATUM: _____

THETA ANGLE: _____

FIELD BOOK: 96-06

PAGE _____

CORNER NO. 31
SECTION 8
TOWN 4N
RANGE 3W

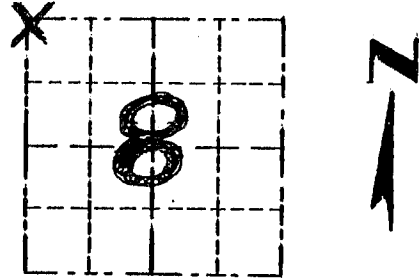


LOCATION
(Indicated by "X")

BASIS FOR MONUMENT LOCATION

(Use reverse side if necessary)

CORNER SET IN 1833 BY
ROBERT CLARK. ORIGINAL BEARING SEAL:
TREES WERE UNRECOVERABLE. NO RECORD
OF CORNER FOUND SINCE ORIGINAL
SURVEYS. CORNER SET AT A OCCUPIED
FENCE CORNER. VERIFIED THIS LOCATION
USING EDM METHODS.

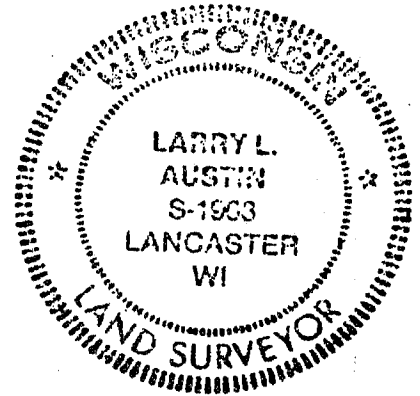

CERTIFIED CORRECT

Larry L. Austin
Registered Land Surveyor

DATE: 9/30/96

TIE SKETCH

Show at least three (3) ties and monument

LEGEND

● 3/4" x 24" IRON BAR
SET W/ CAP.

○ 1/2" x 18" IRON BAR
SET

— — — EXISTING FENCE

PASTURE

WOODS

NO SCALE

