


GRANT COUNTY

Survey Monument Record

TYPE OF MONUMENT 3/4" X 24" IRON BAR SET
 STATE PLANE COORDINATES: N W/ CAP
 E _____
 ELEVATION — M.S.L. DATUM: _____
 THETA ANGLE: _____
 FIELD BOOK: 96-06
 PAGE _____


CORNER NO. 51
 SECTION 8
 TOWN 4N
 RANGE 3W

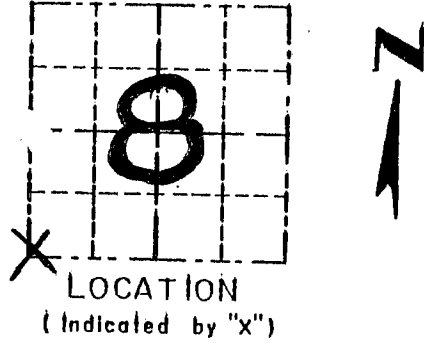

BASIS FOR MONUMENT LOCATION

(Use reverse side if necessary)

CORNER SET IN 1833 BY ROBERT CLARK; ORIGINAL BEARING TREES WERE UNRECOVERABLE. NO RECORD OF COR, SEAL: FOUND SINCE ORIGINAL SURVEYS. CORNER SET ONLINE WITH OCCUPIED FENCE, EAST/WEST FOR NORTHING. CORNER WAS ALSO SET IN OCCUPIED CENTERLINE FOR EASTING, VERIFIED ITS LOCATION 1/2 MILE EAST AND 1 MILE NORTH USING EDM METHODS.

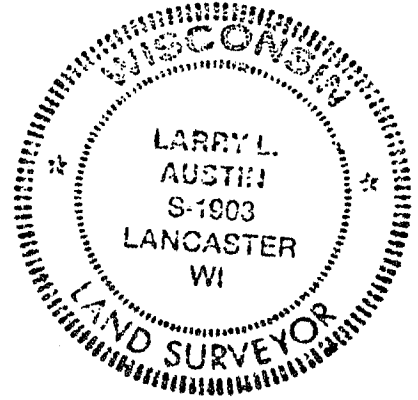

CERTIFIED CORRECT

Larry L. Austin
 Registered Land Surveyor

DATE: 9/30/96

TIE SKETCH

Show at least three (3) ties and monument

