

GRANT COUNTY


Survey Monument Record

TYPE OF MONUMENT 3/4" X 24" IRON BAR SET
 STATE PLANE COORDINATES: N W/CAP.
 E _____
 ELEVATION — M.S.L. DATUM: _____
 THETA ANGLE: _____
 FIELD BOOK: 96-06
 PAGE _____

CORNER NO. 35
 SECTION 8
 TOWN 4N
 RANGE 3W

BASIS FOR MONUMENT LOCATION

(Use reverse side if necessary)

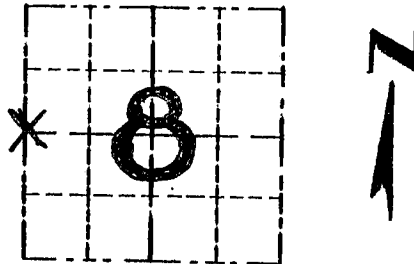

LOCATION
(Indicated by "X")

CORNER SET IN 1833 BY
 ROBERT CLARK, ORIGINAL BEARING SEAL:
 TREES WERE UNRECOVERABLE. NO RECORD
 OF CORNER FOUND SINCE ORIGINAL
 SURVEYS. CORNER SET IN A OCCUPIED
 FENCE NORTH / SOUTH FOR EASTING,
 CORNER SET MIDWAY BETWEEN NORTH WEST
 CORNER AND SOUTHWEST CORNER FOR
 NORTHING. I VERIFIED THIS LOCATION
 USING EDM METHODS.



CERTIFIED CORRECT

Larry L. Austin
 Registered Land Surveyor

DATE: 9/30/96

TIE SKETCH

Show at least three (3) ties and monument

