

# GRANT COUNTY CERTIFIED LAND CORNER

CORNER NUMBER 89

**CERTIFICATE:**


I, Larry L. Austin, do hereby certify that on the 5th day of May 2000, I found evidence of the Southeast corner of Section 20, Town 4 North, Range 3 West, of the 4th Principal Meridian, and I re-established said corner according to the Wisconsin statutes as shown and described hereon.

Dated this 12th day of May, 2000

*Larry L. Austin*  
Larry L. Austin S-1903



SEAL

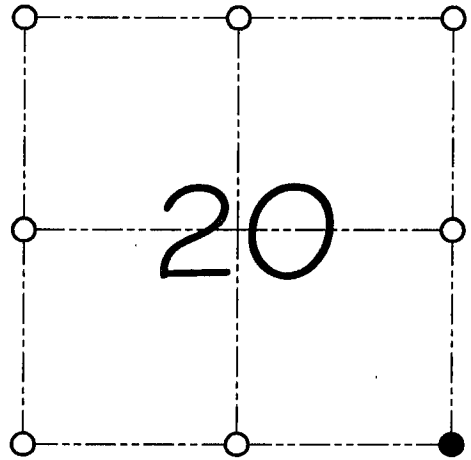

● = CORNER LOCATION

SOUTHEAST CORNER OF  
SECTION 20, T 4 N R 3 W  
TOWN OF SOUTH LANCASTER

**HISTORY OF ORIGINAL CORNER ESTABLISHMENT:**

Corner was originally set in 1833 by Robert Clark.  
In 1878 Joel Barber tied to and set a Stone.

**DESCRIPTION OF CORNER EVIDENCE FOUND:**

I found an existing pipe post in concrete and accepted its location after an E.D.M. & G.P.S. traverse of the area.

**DESCRIPTION OF CORNER AND WITNESS MONUMENTS, references and accessories used to perpetuate the original or re-established location of this corner**

WITNESS TO THE CORNER LOCATION: SHANE AUSTIN & SHELBY BLINDERT

**SKETCH:**

