


Survey Monument Record

TYPE OF MONUMENT 3/4" X 24" IRON
BAR SET

CORNER NO. 93
SECTION 30
TOWN 4N
RANGE 2W

FIELD BOOK: 96-14
PAGE 26

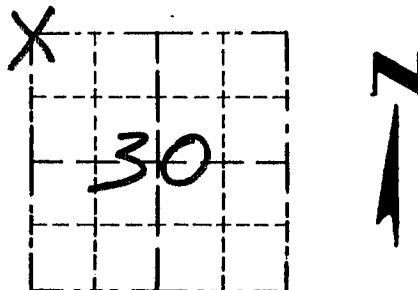

LOCATION
(Indicated by "X")


BASIS FOR MONUMENT LOCATION

(Use reverse side if necessary)

Show info such as: History of corner, with reference to Vol. and pg., dates, surveyor; exact description of monument replaced; if location computed, by taped or EDM traverse; landowner, remarks, etc.

SEAL:

CORNER SET IN 1832
BY SIBLEY. NO RECORD
OF CORNER FOUND SINCE ORIGINAL
SURVEY. I SET THE
CORNER AT THE RECORDED
OFFSET OF 1.21 CHAINS SOUTH OF
THE NE COR. OF SEC. 25 & ON THE EAST
LINE OF SECTION 25 T4N R3W.
VERIFIED ITS LOCATION
USING EDM METHODS.

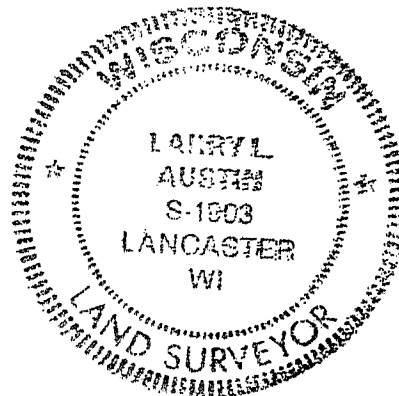

CERTIFIED CORRECT

Larry L. Austin
Registered Land Surveyor

DATE: 1-27-97

TIE SKETCH

Show at least three (3) ties and monument

LEGEND

- ⊕ 3/4" X 24" IRON BAR SET
- 1/2" X 15" IRON BAR SET
- XX EXISTING FENCE

