


U.S. PUBLIC LAND SURVEY MONUMENT RECORD - GRANT COUNTY, WI
 Section 25, Town 4 North Range 3 West, Town of South Lancaster

CERTIFICATE:

I, Jimmy D. Rose, do hereby certify that the corner location on this record was determined by me and/or under my direct supervision and that this U.S. Public Land Survey Monument Record is correct and complete to the best of my knowledge and belief.

Dated this 12th day of November, 2012

Jimmy D. Rose
 Jimmy D. Rose S-1911

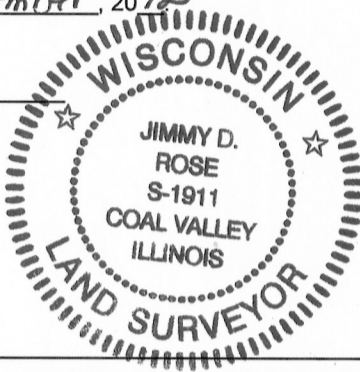

● = CORNER LOCATION

HISTORY OF CORNER ESTABLISHMENT: CORNER AND ACCESSORIES ESTABLISHED BY DAVID BURBACH IN 1996; FOUND BY THOMAS L. BUCK IN 1998.

DESCRIPTION OF CORNER EVIDENCE FOUND: RE-TRACED SURVEY BY DAVID BURBACH AND RE-SET OBLITERATED CORNER MONUMENT AND ACCESSORIES AS SHOWN.

DESCRIPTION OF CORNER AND WITNESS MONUMENTS, references and accessories used to perpetuate the original or re-established location of this corner.

SKETCH:

