


Survey Monument Record

CORNER NO. 111
 SECTION 31
 TOWN 4 N
 RANGE 3 W

TYPE OF MONUMENT 3/4" x 24" IRON BAR SET
 STATE PLANE COORDINATES: N _____
 E _____
 ELEVATION — M.S.L. DATUM: _____
 THETA ANGLE: _____
 FIELD BOOK: 9504
 PAGE 6

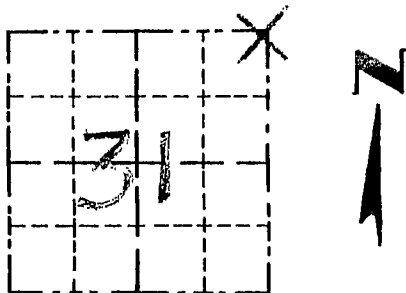

LOCATION
 (Indicated by "X")

BASIS FOR MONUMENT LOCATION

(Use reverse side if necessary)

Show info such as: History of corner, with reference to Vol. and pg., dates, surveyor; exact description of monument replaced; if location computed, by taped or EDM traverse; landowner, remarks, etc.

SEAL:

CORNER ORIGINALLY SET IN 1833 BY CLARK & EXTERIOR BOUNDARY OF THE SECTION WAS RESURVEYED IN 1899 BY CHARLES SAMPSON; I RE-ESTABLISHED THE CORNER AT OCCUPIED LOCATION & VERIFIED BY EDM TRAVERSE.


CERTIFIED CORRECT

Rodney R. Rust
 Registered Land Surveyor

DATE: 4/22/95

TIE SKETCH

Show at least three (3) ties and monument

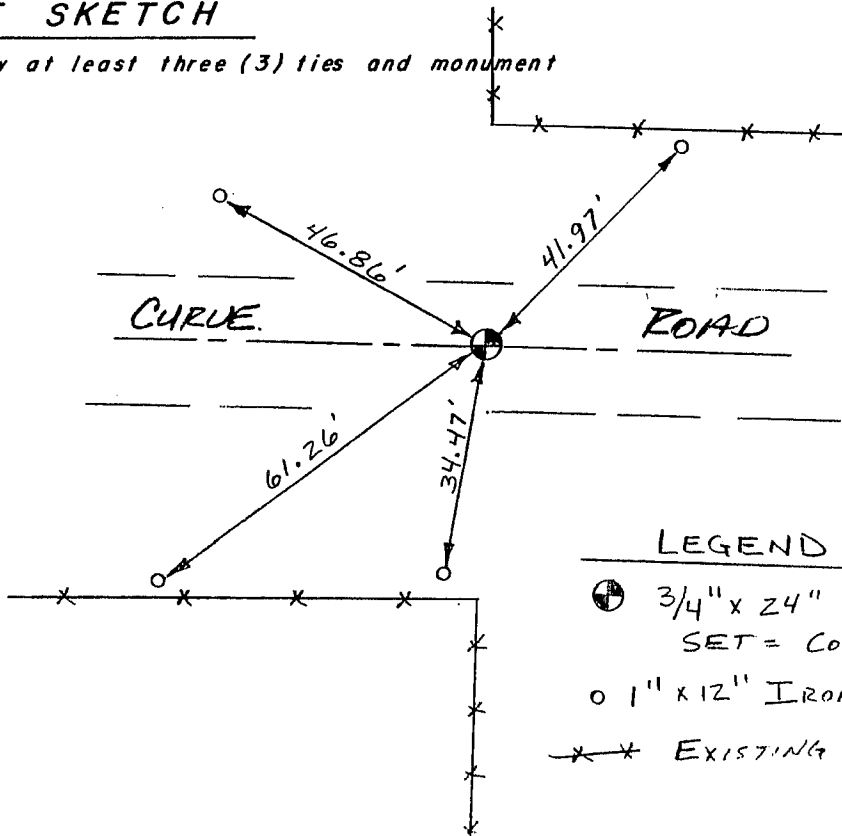

LEGEND

- ⊕ 3/4" x 24" SMOOTH BAR SET = CORNER
- 1" x 12" IRON PIPE SET
- *** EXISTING FENCE

N
 NO SCALE