


X

Survey Monument Record

TYPE OF MONUMENT No MONUMENT
PLACED

CORNER NO. 24
SECTION 11
TOWN 4N
RANGE 4W

FIELD BOOK: 96-04
PAGE 15

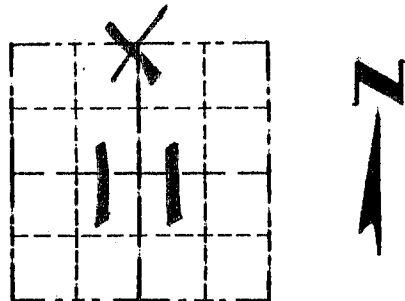

LOCATION
(Indicated by "X")


BASIS FOR MONUMENT LOCATION

(Use reverse side if necessary)

Show info such as: History of corner, with reference to Vol. and pg.; dates, surveyor; exact description of monument replaced; if location computed, by taped or EDM traverse; landowner, remarks, etc.

SEAL:

NO RECORD FOUND OF CORNER SINCE ORIGINAL SURVEYS; I SET THE CORNER BY PROPORTIONING FROM AN EXISTING FENCE CORNER 1/2 MILE EAST AND AN EXISTING MONUMENT 1/2 MILE WEST; VERIFIED BY EDM TRAVERSE OF THE AREA.

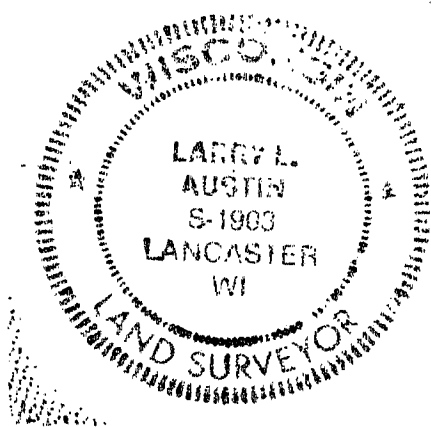

CERTIFIED CORRECT

Larry L. Austin
Registered Land Surveyor

DATE: 7/17/96

TIE SKETCH

Show at least three (3) ties and monument

LEGEND

- ⊕ NO MONUMENT PLACED
- 3/4" X 24" IRON BAR SET FIELD
- 3/8" X 15" IRON ROD SET

