


# GRANT COUNTY

## Survey Monument Record

TYPE OF MONUMENT ALUMINUM MONUMENT  
STATE PLANE COORDINATES: N \_\_\_\_\_  
E \_\_\_\_\_  
ELEVATION — M.S.L. DATUM: \_\_\_\_\_  
THETA ANGLE: \_\_\_\_\_  
FIELD BOOK: 9321  
PAGE \_\_\_\_\_

CORNER NO. \_\_\_\_\_  
SECTION 3  
TOWN 4 N  
RANGE 4 W

E 1/4 COR - SEC 3

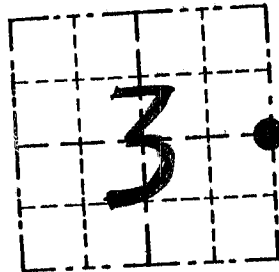

LOCATION  
(Indicated by "●")


### BASIS FOR MONUMENT LOCATION

(Use reverse side if necessary)

Show info such as: History of corner, with reference to Vol. and pg., dates, surveyor; exact description of monument replaced; if location computed, by taped or EDM traverse; landowner, remarks, etc.

CORNER WAS SET AT OCCUPIED LOCATION; VERIFIED BY EDM TRAVERSE.

SEAL:

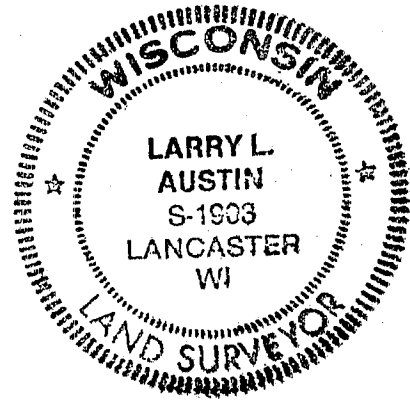

CERTIFIED CORRECT

Larry L. Austin  
Registered Land Surveyor

DATE: 12/30/93

### TIE SKETCH

Show at least three (3) ties and monument

#### LEGEND

- ALUM. MON. SET = CORNER
- ▲ RAILROAD SPIKE SET = TIES
- 1" IRON PIPE
- ✕ EXISTING FENCE

