

GRANT COUNTY

Survey Monument Record

CORNER NO. 55
 SECTION 18
 TOWN 4N
 RANGE 4W

TYPE OF MONUMENT 3/4" X 24" IRON BAR


STATE PLANE COORDINATES: N SET
 E _____

ELEVATION — M.S.L. DATUM: _____

THETA ANGLE: _____

FIELD BOOK: 96-16

PAGE _____

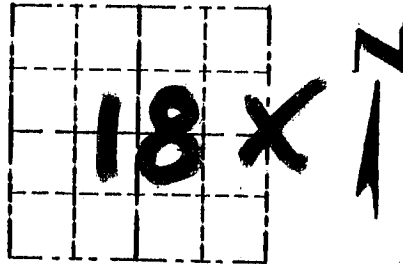


LOCATION
(Indicated by "X")

BASIS FOR MONUMENT LOCATION

(Use reverse side if necessary)

CORNER SET IN 1833 BY CLARK. ORIGINAL MOUND SEAL: IN PRAIRIE WAS UNRECOVERABLE. NO RECORD OF CORNER FOUND SINCE ORIGINAL SURVEYS. CORNER SET AT A OCCUPIED FENCE WEST FOR NORTHING, CENTERLINE OF BUDWORTH SCHOOL ROAD FOR EASTING, VERIFIED ITS LOCATION USING EDM METHODS.

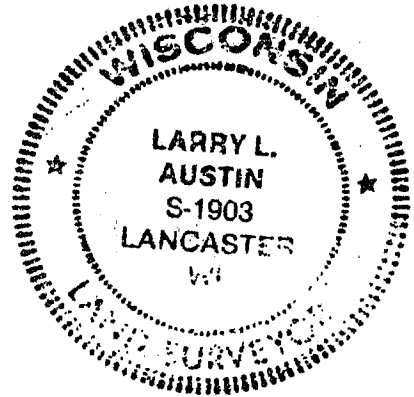

CERTIFIED CORRECT

Larry L. Austin
 Registered Land Surveyor

DATE: 10-10-96

TIE SKETCH

Show at least three (3) ties and monument

LEGEND

● 3/4" X 24" IRON BAR SET

• 1/2" X 18" IRON BAR SET

* * * EXISTING FENCE

