


Survey Monument Record

TYPE OF MONUMENT 3/4" x 24" IRON
BAR SET

CORNER NO. 102
 SECTION 36
 TOWN 4W
 RANGE 4N

FIELD BOOK: 96-19
 PAGE _____

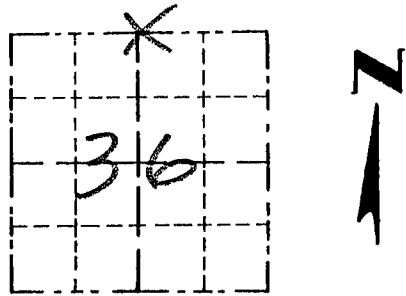

LOCATION
 (Indicated by "X")


BASIS FOR MONUMENT LOCATION

(Use reverse side if necessary)

Show info such as: History of corner, with reference to Vol. and pg., dates, surveyor; exact description of monument replaced; if location computed, by taped or EDM traverse; landowner, remarks, etc.

SEAL:

CORNER SET IN 1833 BY ROBERT CLARK. NO RECORD OF CORNER FOUND SINCE ORIGINAL SURVEYS. CORNER WAS SET AT A RECORDED OFFSET FROM AN EXISTING FENCE SOUTH FOR EASTING, NORTHING WAS SET IN THE EXISTING EAST/WEST CENTERLINE. VERIFIED THIS LOCATION USING EDM METHODS.

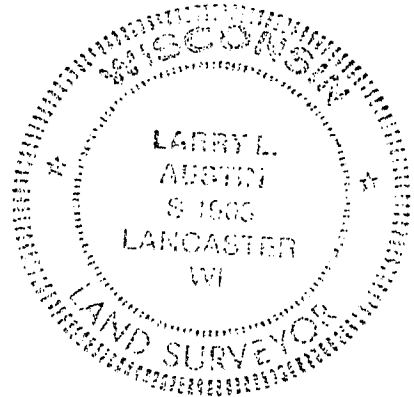

CERTIFIED CORRECT

Larry L. Austin
 Registered Land Surveyor

DATE: 1/12/98

TIE SKETCH

Show at least three (3) ties and monument

LEGEND

- ⊙ 3/4" x 24" IRON BAR SET
- 1/2" x 15" IRON BAR SET
- xx EXISTING FENCE

