

GRANT COUNTY

Survey Monument Record

TYPE OF MONUMENT 3/4" X 24" IRON BAR SET

STATE PLANE COORDINATES: N _____
E _____

ELEVATION — M.S.L. DATUM: _____

THETA ANGLE: _____

FIELD BOOK: 96-18

PAGE _____

CORNER NO. 103


SECTION 26

TOWN 4N

RANGE 4W

BASIS FOR MONUMENT LOCATION

(Use reverse side if necessary)

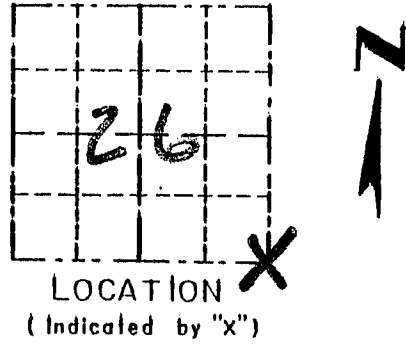

LOCATION
(Indicated by "X")

SEAL:


JOEL BARBER SET 30X24X7

ROCK. THE ROCK WAS UNRECOVERABLE.

I ACCEPTED THE CENTERLINE OF PIGEON RIVER ROAD FOR NORTHING.

I ACCEPTED THE EAST SIDE OF A GATE NORTH OF ROAD AND A JOG IN R.O.W. FENCE SOUTH OF ROAD FOR EASTING. THIS LOCATION

FIT VERY WELL NORTH, EAST AND WEST. VERIFIED ITS LOCATION USING EDM METHODS.

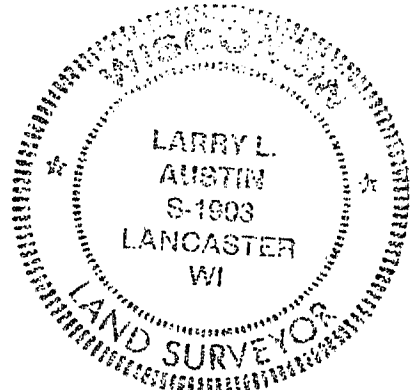

CERTIFIED CORRECT

Larry L. Austin
Registered Land Surveyor

DATE: 12-2-96

TIE SKETCH

Show at least three (3) ties and monument

