

GRANT COUNTY

Survey Monument Record

TYPE OF MONUMENT 3/4" X 24" IRON BAR SET

STATE PLANE COORDINATES: N _____
E _____

ELEVATION — M.S.L. DATUM: _____

THETA ANGLE: _____

FIELD BOOK: 96-18


PAGE _____

CORNER NO. 104

SECTION 26

TOWN 4N

RANGE 4W

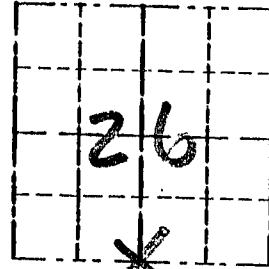


LOCATION
(Indicated by "X")



BASIS FOR MONUMENT LOCATION

(Use reverse side if necessary)

CORNER SET IN 1833 BY
ROBERT CLARK, IN 1875
JOEL BARBER LOCATED THE SEAL:
CORNER EQUIDISTANT. I FOUND
A WHITE OAK WHICH BARBER
TIED TO. I RESET THE
CORNER USING THE TREE,
VERIFIED ITS LOCATION USING
EDM METHODS.

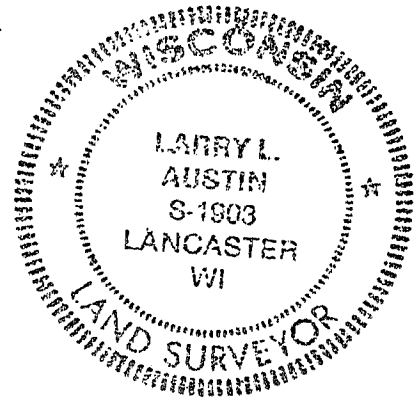

CERTIFIED CORRECT

Larry L. Austin
Registered Land Surveyor

DATE: 12-2-96

TIE SKETCH

Show at least three (3) ties and monument

LEGEND

⊕ 3/4" X 24" IRON BAR SET

○ 1/2" X 18" IRON BAR SET

XX EXISTING FENCE

