

GRANT COUNTY

Survey Monument Record

TYPE OF MONUMENT 3/4" X 24" IRON BAR SET

STATE PLANE COORDINATES: N _____
E _____


ELEVATION — M.S.L. DATUM: _____

THETA ANGLE: _____

FIELD BOOK: 96-18

PAGE _____

CORNER NO. 99
SECTION 26
TOWN 4N
RANGE 4W

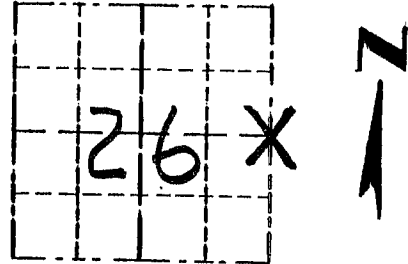


LOCATION
(Indicated by "X")

BASIS FOR MONUMENT LOCATION

(Use reverse side if necessary)

CORNER SET IN 1833 BY
ROBERT CLARK. IN 1875 JOEL
BARBER FOUND THE ORIGINAL SEAL:
CORNER. I FOUND AND ACCEPTED
A OCCUPATIONAL LOCATION OF A
FENCE EAST / WEST AND THE
EAST MOST SIDE OF A GATE,
VERIFIED ITS LOCATION USING
EDM METHODS.

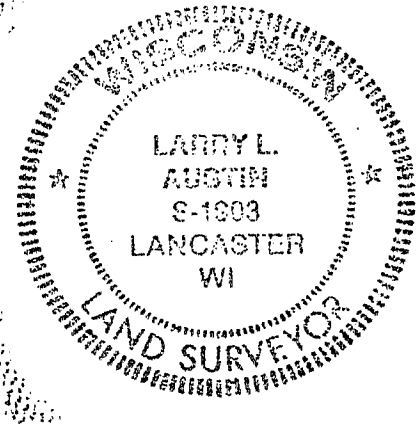

CERTIFIED CORRECT

Larry L. Austin
Registered Land Surveyor

DATE: 12-2-96

TIE SKETCH

Show at least three (3) ties and monument

LEGEND

⊕ 3/4" X 24" IRON BAR SET

○ 1/2" X 18" IRON BAR SET

--- EXISTING FENCE

