

GRANT COUNTY CERTIFIED LAND CORNER

CORNER NUMBER 106

CERTIFICATE:

I, Larry L. Austin, do hereby certify that on the 5th day of October, 2000, I found no evidence of the South 1/4 corner of Section 27, Town 4 North, Range 4 West, of the 4th Principal Meridian, and I re-established said corner according to the Wisconsin statutes as shown and described hereon.


Dated this 15th day of November, 2000

Larry L. Austin
Larry L. Austin S-1903

Grant County Corr
N 500774.0
E 786750.5



SEAL

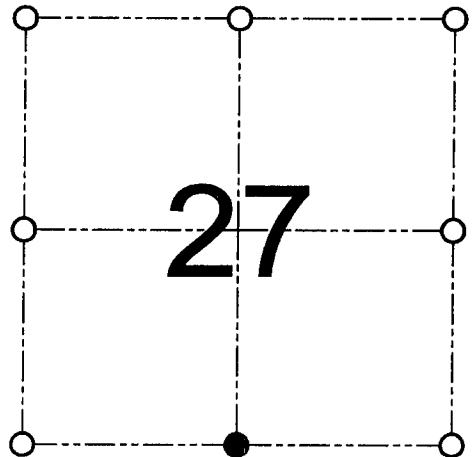

● = CORNER LOCATION

SOUTH 1/4 CORNER OF
SECTION 27, T 4 N R 4 W
TOWN OF BEETOWN

HISTORY OF ORIGINAL CORNER ESTABLISHMENT:

Corner was originally set in 1833 by Clark.
In 1877 Barber tied to the corner.

DESCRIPTION OF CORNER EVIDENCE FOUND:

I reset the corner proportionately and online with the Southwest and Southeast corners of Section 27. Verified it's location using EDM & GPS methods.

DESCRIPTION OF CORNER AND WITNESS MONUMENTS, references and accessories used to perpetuate the original or re-established location of this corner

WITNESS TO THE CORNER LOCATION: SHELBY BLINDERT & BOBBY SEDGWICK

SKETCH:

