

# U.S. PUBLIC LAND SURVEY MONUMENT RECORD - GRANT COUNTY, WI



Section 3, Town 3 North Range 4 West, Town of Waterloo

**CERTIFICATE**

I, Larry L. Austin, do hereby certify that the corner location on this record was determined by me and/or under my direct supervision and that this U.S. public land survey monument record is correct and complete to the best of my knowledge and belief.

Dated this 26th day of February 2008

*Larry L. Austin*  
Larry L. Austin S-1903

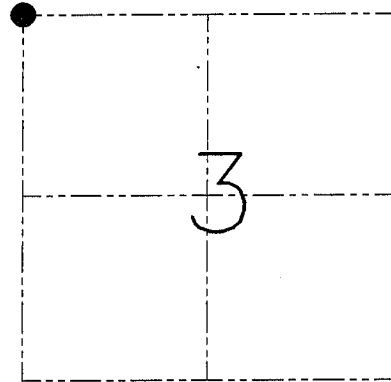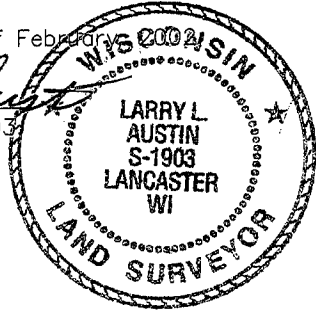

● = CORNER LOCATION

**HISTORY OF CORNER ESTABLISHMENT**

Corner was originally set in 1833 by Lucius Lyon.  
No other record of the corner was found.

**DESCRIPTION OF CORNER EVIDENCE FOUND**


I reset the corner at the recorded offset from the Southeast corner of Section 33. Verified this location using EDM & GPS methods.

**DESCRIPTION OF CORNER AND WITNESS MONUMENTS**, references and accessories used to perpetuate the original or re-established location of this corner. Witnesses to the corner location Bobby Sedgwick & Shane Austin & Shelby Blindert

**SKETCH:**

**LEGEND**

- Number 8 x 30" rebar set with Grant County Aluminum Cap
- Number 6 rebar found
- x— Approximate existing fence

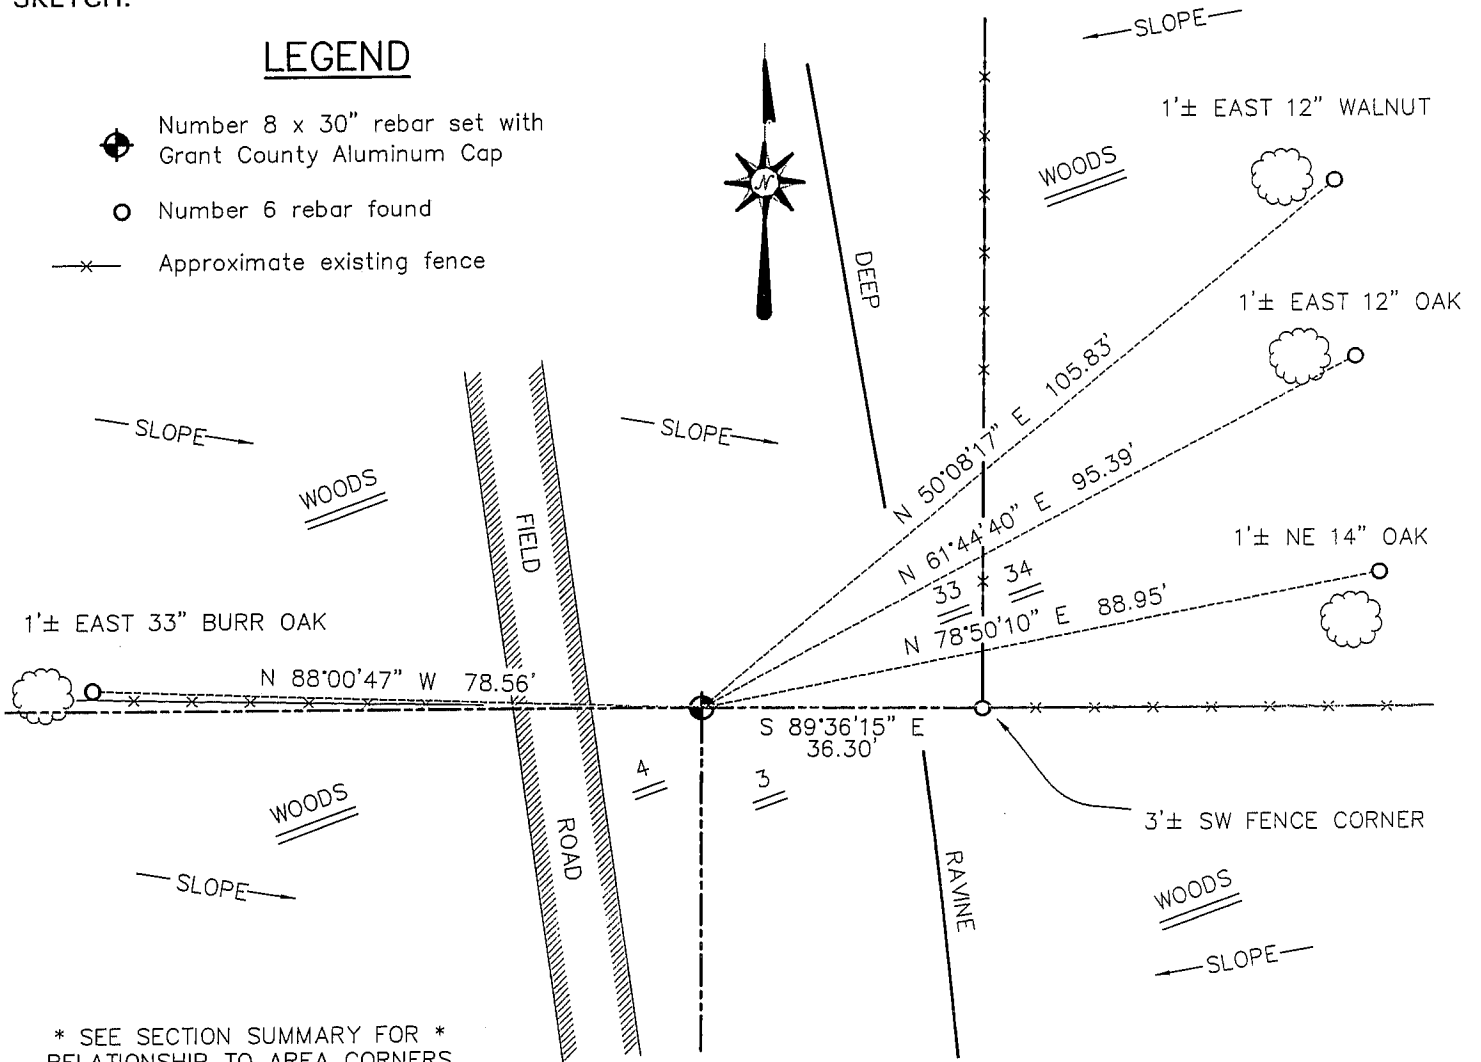

\* SEE SECTION SUMMARY FOR \*  
RELATIONSHIP TO AREA CORNERS

SKETCH NOT TO SCALE

**AUSTIN ENGINEERING, LLC**

4211 HWY 81 EAST, LANCASTER, WI 53813  
PHONE 608-723-6363 FAX 608-723-6702

FIELDBOOK: SDR33, 2131  
G: \T3NR4W\15A  
C: \SWA\TIE\T3NR4W\07  
CREW: BS-SB-SA-BD

DRAWN BY: SW AUSTIN  
APPROVED: LL AUSTIN

CORNER NUMBER 07

Survey Monument Record

CORNER NO. 127  
SECTION 34  
TOWN 4N  
RANGE 4W


TYPE OF MONUMENT GRANT COUNTY MONUMENT  
STATE PLANE COORDINATES: N \_\_\_\_\_  
E \_\_\_\_\_

ELEVATION — M.S.L. DATUM: \_\_\_\_\_

THETA ANGLE: \_\_\_\_\_

FIELD BOOK: 95-10

PAGE (10)

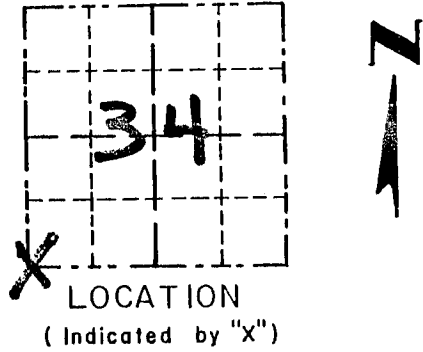

BASIS FOR MONUMENT LOCATION

(Use reverse side if necessary)

GRANT COUNTY MONUMENT  
PLACED AT FENCE INTERSECTION  
NORTH-EAST-WEST. VERIFIED  
BY EDM TRAVERSE OF THE  
AREA.

SEAL:

CERTIFIED CORRECT

*Rory J. Aust*  
Registered Land Surveyor

DATE: 1-8-96

TIE SKETCH

Show at least three (3) ties and monument

