


GRANT COUNTY

REC'D JAN 29 1996

Survey Monument Record

CORNER NO. 117
 SECTION 34
 TOWN 4N
 RANGE 4W

TYPE OF MONUMENT GRANT COUNTY MONUMENT SET
 STATE PLANE COORDINATES: N _____
 E _____
 ELEVATION — M.S.L. DATUM: _____
 THETA ANGLE: _____
 FIELD BOOK: 95-10
 PAGE 10

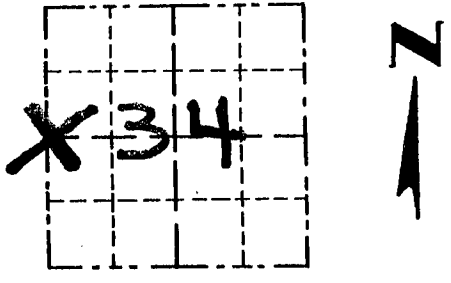


LOCATION
(Indicated by "X")

BASIS FOR MONUMENT LOCATION (Use reverse side if necessary)

GRANT COUNTY MONUMENT
 PLACED AT CORNER OF FENCE
 SOUTH AND EAST. VERIFIED
 BY EDM TRAVERSE OF THE
 AREA.

SEAL:

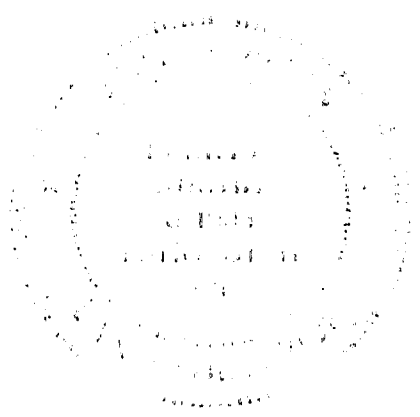

CERTIFIED CORRECT
Kerry J. Amato
 Registered Land Surveyor
 DATE: 1-6-96

TIE SKETCH

Show at least three (3) ties and monument

