


Survey Monument Record

TYPE OF MONUMENT 3/4" X 24" IRON
BAR SET

CORNER NO. 18
 SECTION 3
 TOWN 4N
 RANGE 5W

FIELD BOOK: 97-20
 PAGE _____

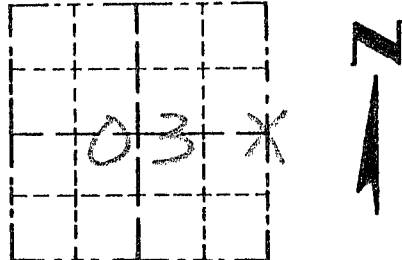

LOCATION
 (Indicated by "X")


BASIS FOR MONUMENT LOCATION

(Use reverse side if necessary)

Show info such as: History of corner, with reference to Vol. and pg., dates, surveyor; exact description of monument replaced; if location computed, by taped or EDM traverse; landowner, remarks, etc.

SEAL:

CORNER SET IN 1832 BY ROBERT CLARK. NO RECORD OF CORNER FOUND SINCE ORIGINAL SURVEY; CORNER WAS SET ONLINE BETWEEN THE NORTHEAST AND SOUTHEAST CORNERS FOR EASTING. NORTHING WAS SET BY AN EXISTING EAST/WEST FENCE, VERIFIED ITS LOCATION USING EDM METHODS.

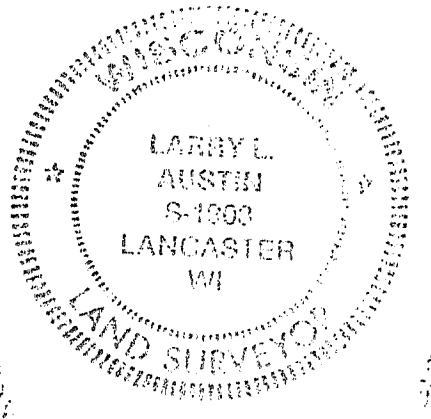

CERTIFIED CORRECT

Larry L. Austin
 Registered Land Surveyor

DATE: 12/31/97

TIE SKETCH

Show at least three (3) ties and monument

LEGEND

- 3/4" X 24" IRON BAR SET
- 1/2" X 15" IRON BAR SET
- XX EXISTING FENCE

