


GRANT COUNTY

Survey Monument Record

TYPE OF MONUMENT 1" IRON PIPE FOUND
 STATE PLANE COORDINATES: N _____
 E _____
 ELEVATION — M.S.L. DATUM: _____
 THETA ANGLE: _____
 FIELD BOOK: _____
 PAGE _____

CORNER NO. 47
 SECTION 15
 TOWN 4N
 RANGE 5W
NW COR.

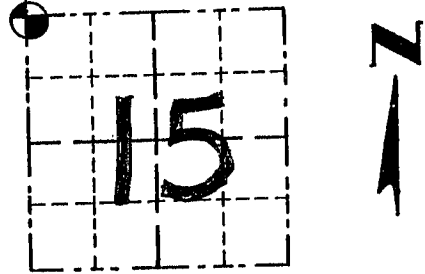

LOCATION
 (Indicated by "X")


BASIS FOR MONUMENT LOCATION

(Use reverse side if necessary)

Show info such as: History of corner, with reference to Vol. and pg., dates, surveyor; exact description of monument replaced; if location computed, by taped or EDM traverse; landowner, remarks, etc.

SEAL:

FOUND A 1" IRON PIPE AT
 THE CORNER LOCATION, I
 ACCEPTED ITS LOCATION AFTER
 VERIFICATION BY EDM TRAVERSE.

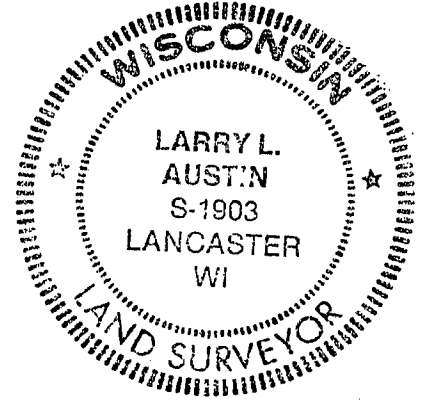


CERTIFIED CORRECT

Larry L. Austin
 Registered Land Surveyor

DATE: 1-6-95

TIE SKETCH

Show at least three (3) ties and monument

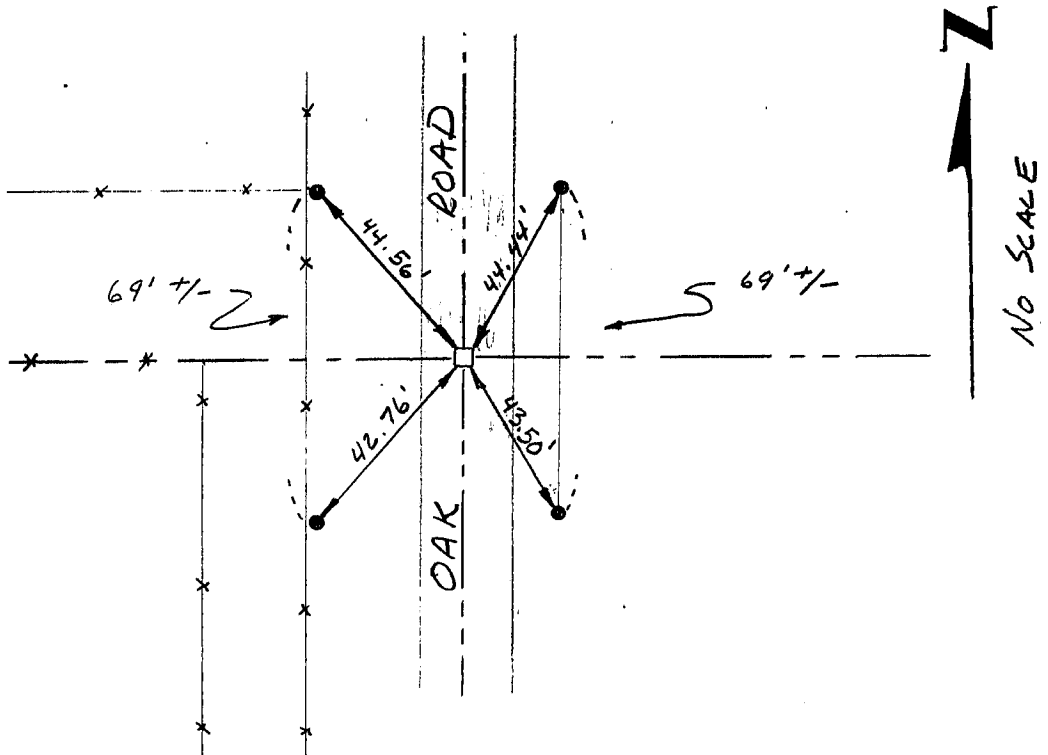

LEGEND

- 1" IRON PIPE FND.
- 1" x 24" IRON PIPE PLACED AS TIE
- xx EXISTING FENCE