

GRANT COUNTY

Survey Monument Record

TYPE OF MONUMENT 1"X24" IRON BARSET

STATE PLANE COORDINATES: N _____
E _____

ELEVATION — M.S.L. DATUM: _____

THETA ANGLE: _____

FIELD BOOK: _____

PAGE _____


CORNER NO. 45

SECTION 15

TOWN 4N

RANGE 5W

NE COR.

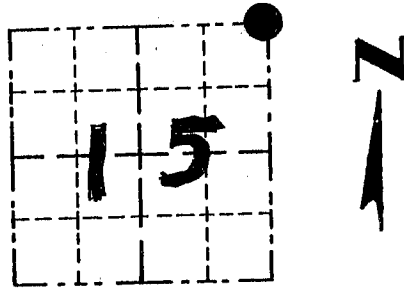

LOCATION
(Indicated by ●)


BASIS FOR MONUMENT LOCATION

(Use reverse side if necessary)

Show info such as: History of corner, with reference to Vol. and pg., dates, surveyor; exact description of monument replaced; if location computed, by taped or EDM traverse; landowner, remarks, etc.

SEAL:

NO RECORD FOUND OF CORNER
SINCE ORIGINAL SURVEYS; E-W
LOCATION I ACCEPTED FENCE
& SET AT EQUAL DISTANCE
FROM E¹/₄ CORNER SEC. 10 &
E¹/₄ CORNER OF SEC. 15. VERIFIED
BY EDM TRAVERSE OF THE AREA.

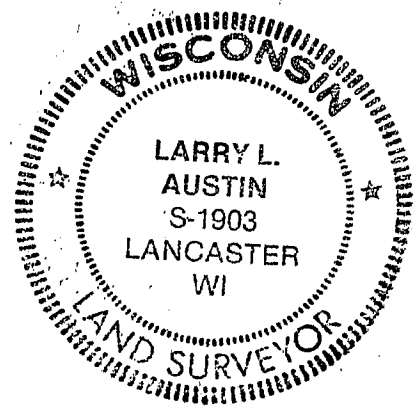


CERTIFIED CORRECT

Registered Land Surveyor

DATE: 1-15-95

TIE SKETCH

Show at least three (3) ties and monument

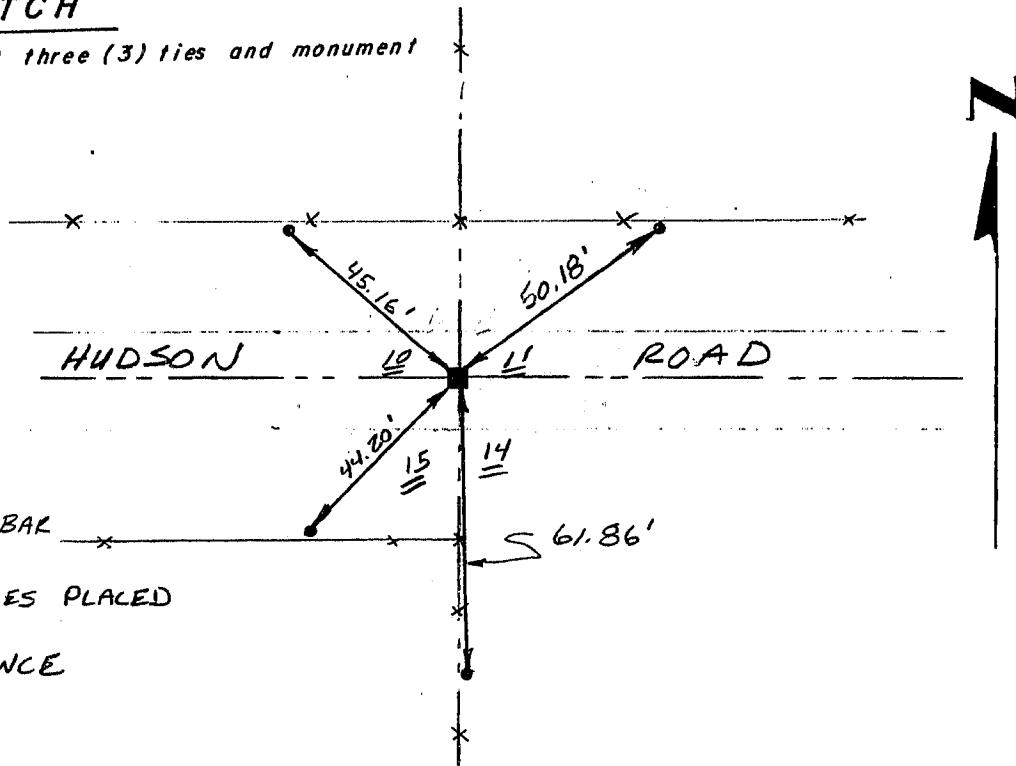

NO SCALE

LEGEND

- 1"X24" IRON BAR
- 1"X12" IRON PIPES PLACED
- xx EXISTING FENCE