

# GRANT COUNTY

## Survey Monument Record

TYPE OF MONUMENT 3/4" X 24" IRON BAR SET

STATE PLANE COORDINATES: N \_\_\_\_\_  
E \_\_\_\_\_


ELEVATION — M.S.L. DATUM: \_\_\_\_\_

THETA ANGLE: \_\_\_\_\_

FIELD BOOK: 96-16

PAGE \_\_\_\_\_

CORNER NO. 54  
SECTION 18  
TOWN 4N  
RANGE 4W

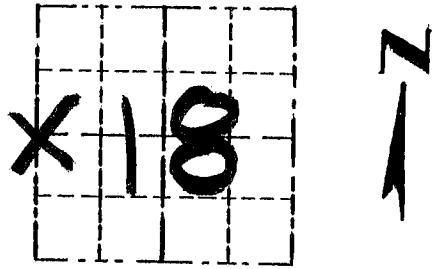


LOCATION  
(Indicated by "X")

### BASIS FOR MONUMENT LOCATION

(Use reverse side if necessary)

CORNER SET IN 1832 BY  
SIBLEY. ORIGINAL LOCATION  
OF CORNER WAS UNRECOVERABLE.  
NO RECORD OF CORNER FOUND  
SINCE ORIGINAL SURVEYS. CORNER  
SET AT AN OCCUPIED FENCE  
CORNER. VERIFIED ITS LOCATION  
USING EDM METHODS.

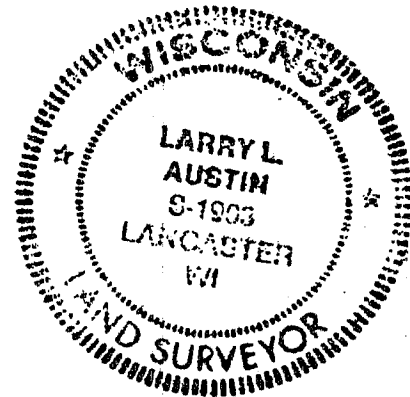

CERTIFIED CORRECT

*Larry L. Austin*  
Registered Land Surveyor

DATE: 10/10/96

### TIE SKETCH

Show at least three (3) ties and monument

#### LEGEND

⊕ 3/4" X 24" IRON BAR SET

○ 1/2" X 18" IRON BAR SET

XX EXISTING FENCE

