

U.S. PUBLIC LAND SURVEY MONUMENT RECORD

Section 14, Town 4 North Range 5 West, Town of Beetown, Grant County, Wisconsin

CERTIFICATE

I, Larry L. Austin, do hereby certify that the corner location on this record was determined by me and/or under my direct supervision and that this U.S. public land survey monument record is correct and complete to the best of my knowledge and belief.

Larry L. Austin
Larry L. Austin, S-1903



● = CORNER LOCATION

HISTORY OF CORNER

Corner was originally set in 1832 by Robert Clark.
No other record of the corner was found.

CORNER EVIDENCE FOUND


I set the corner at an occupied location.
Verified this location using EDM & GPS methods.

DESCRIPTION OF CORNER AND WITNESS MONUMENTS, references and accessories used to perpetuate the original or re-established location of this corner. Witnesses to monument location Bobby Sedgwick & Brad Digman & Shane Austin

SKETCH:

LEGEND

- ◆ Number 8 x 30" rebar set with Grant County Aluminum cap
- Number 4 x 24" Rebar set with red plastic "TIE" cap
- x— Approximate existing fence

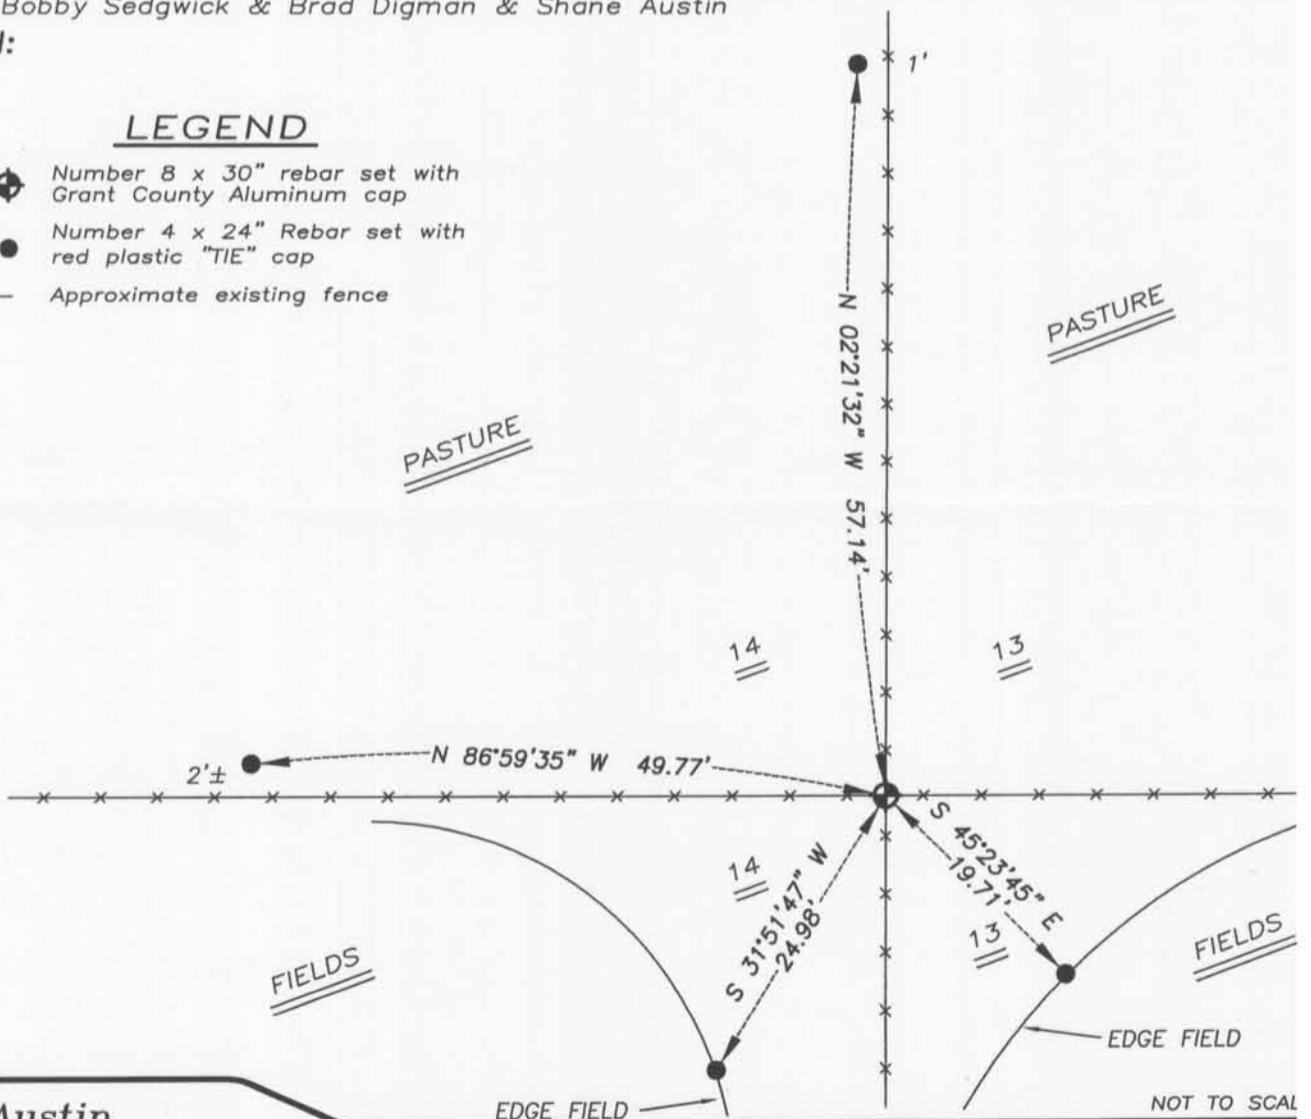

NOT TO SCALE



Austin Engineering LLC

4211 HWY 81 E, LANCASTER, WI 53813
PHONE 608-723-6363 FAX 608-723-6702

JOB NUMBER 09S056
 FIELDBOOK: TDSR, 2901
 G:\T4NR5W\21
 H:\TIE\T4NR5W\59

DRAWN BY: SW AUSTIN
 APPROVED: LL AUSTIN

59

FEB 18 2011