

# U.S. PUBLIC LAND SURVEY MONUMENT RECORD - GRANT COUNTY, WI

Section 22, Town 4 North Range 5 West, Town of Glen Haven East & Beetown West

**CERTIFICATE:**

I, John R. Huseman, do hereby certify that the corner location on this record was determined by me and/or under my direct supervision and that this U.S. Public Land Survey Monument Record is correct and complete to the best of my knowledge and belief.

Dated this 31st day of October, 2012.

John R. Huseman  
John R. Huseman, RLS-1631-8



● = CORNER LOCATION

**HISTORY OF CORNER ESTABLISHMENT:**

Land Survey Monument Record was found for this corner.

**DESCRIPTION OF CORNER EVIDENCE FOUND:**


Corner was re-established from Land Survey Monument Record. Ties were re-set. Verified location by GPS and Total Station measurements. The location fits occupation.

**DESCRIPTION OF CORNER AND WITNESS MONUMENTS,** references and accessories used to perpetuate the original or re-established location of this corner. Witnesses to corner location Ben Scheffner and Rey Munoz

**SKETCH:**

⊗ = 3/4" x 36" Rebar Set

N.W. CORNER OF THE N.W. QUARTER OF SECTION 22, RESET 3/4" REBAR WITH GRANT CO. CAP FROM EXISTING SURVEY DATA

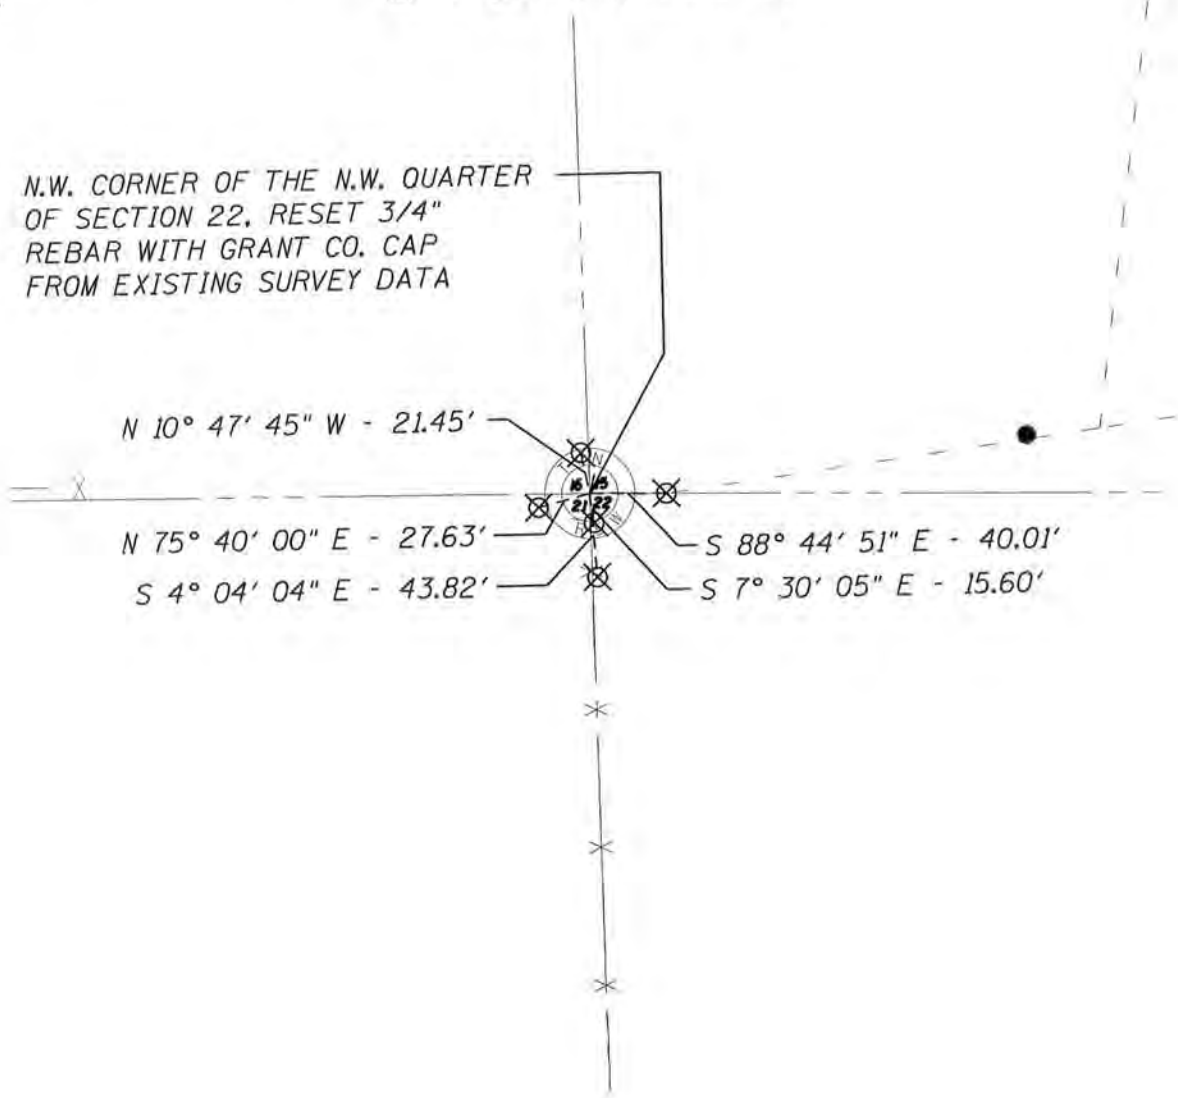


NOV 27 2012 67

# U. S. PUBLIC LAND SURVEY MONUMENT RECORD

INSTRUCTIONS: This record shall show the location of the corner and shall include all of the following nine elements (a through i).

- (a) Identify the corner by reference to the U.S. public land survey system.
- = Corner monument restored.

SOUTHWEST CORNER  
SECTION 15  
TOWN 4 NORTH  
RANGE 5 WEST  
GLEN HAVEN TOWNSHIP  
GRANT COUNTY, WISCONSIN.

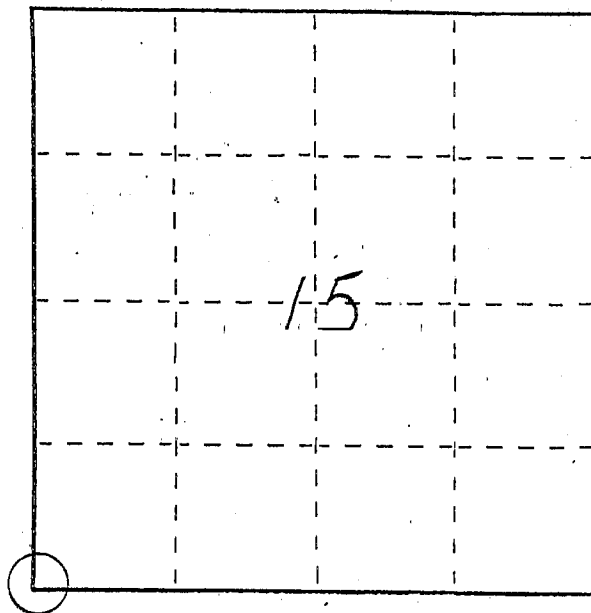


- (b) Describe any record evidence, monument evidence, occupational evidence, testimonial evidence or any other material evidence you considered, and whether the monument was found or placed.

Monument set from existing physical evidence of roads and fences after verification by proportionate measurements from a GPS and EDM survey of the area.

- (c) In the plan view drawing below, provide reference ties to at least 4 witness monuments, or, if the location is within a municipality, to at least 2 witness monuments. (Witness monuments shall be made of concrete, natural stone, iron or other equally durable material, ~~except~~ wood.) Describe witness monuments.

- (d) Show a plan view drawing depicting the relevant monuments and reference ties which is sufficient in detail to enable accurate relocation of the corner monument is disturbed. Indicate north.

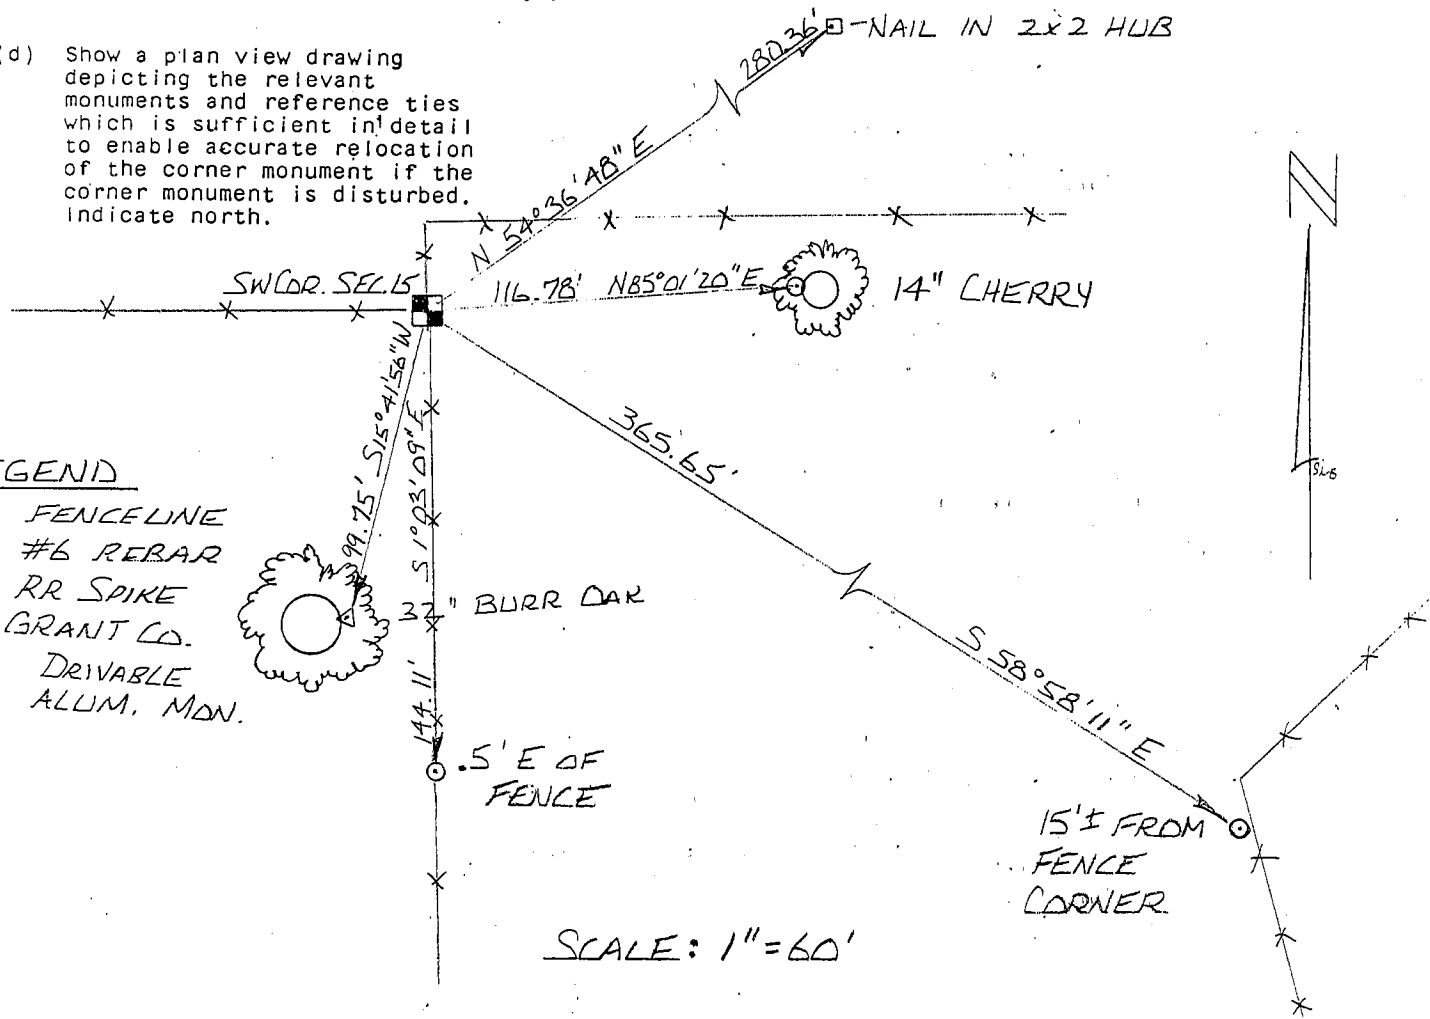

### LEGEND

- \*\* FENCELINE
- #6 REBAR
- △ RR SPIKE
- GRANT CO. DRIVABLE ALUM. MON.

SCALE: 1" = 60'

- (e) Describe any material discrepancy between the location of the corner as restored or reestablished and the location of that corner as previously restored or reestablished by distance and direction. Show the discrepancy on the plan view drawing under (d), above. Show the distances between the corner as previously restored or reestablished and (1) the corner as restored or reestablished, and (2) to at least 2 of the witness monuments shown on the drawing in (d), above.


NONE

- (f) Was the corner restored through acceptance of (1) an obliterated evidence location, or, (2) a found perpetuated location?

(1) AN OBLITERATED EVIDENCE LOCATION.

- (g&h) Was the corner reestablished through lost corner proportionate methods? If so, show the method, including the directions and distances to other public land survey corners used as evidence or used for proportioning in determining the corner location?

No.

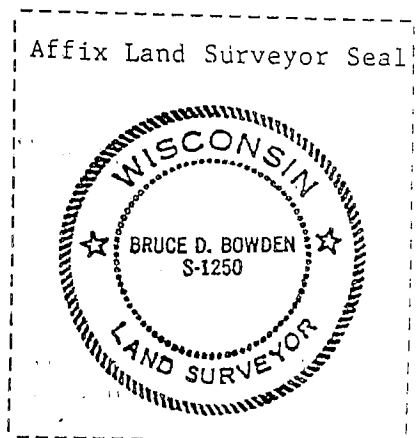

(i) I, BRUCE D. BOWDEN,

(type or print name) certify that the corner location shown on this record was determined by me or under my direction and control and that this U.S. Public Land Survey Monument Record is correct and complete to the best of my knowledge and belief.

Bruce D. Bowden  
Signature

June 21, 1996  
Date