


U.S. PUBLIC LAND SURVEY MONUMENT RECORD

Section 2, Town 4 North Range 6 West, Town of
Glen Haven, Grant County, Wisconsin


CERTIFICATE

I, Larry L. Austin, do hereby certify that the corner location on this record was determined by me and/or under my direct supervision and that this U.S. public land survey monument record is correct and complete to the best of my knowledge and belief.

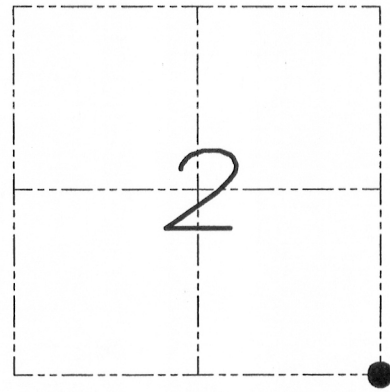

● = CORNER LOCATION

Larry L. Austin
Larry L. Austin, S-1903

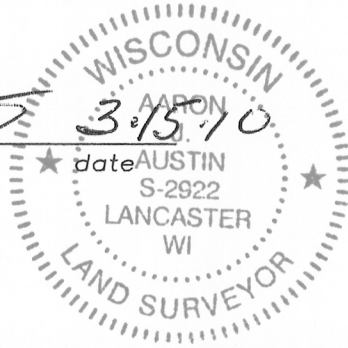

HISTORY OF CORNER


Corner was originally set in 1832 by Robert Clark.
No other record of the corner was found.

CORNER EVIDENCE FOUND

I reset the corner at an occupied fence corner and verified this location by E.D.M. and G.P.S. methods.

DESCRIPTION OF CORNER AND WITNESS MONUMENTS, references and accessories used to perpetuate the original or re-established location of this corner. Witnesses to monument location Bobby Sedgwick & Brad Digman & Shane Austin

SKETCH:

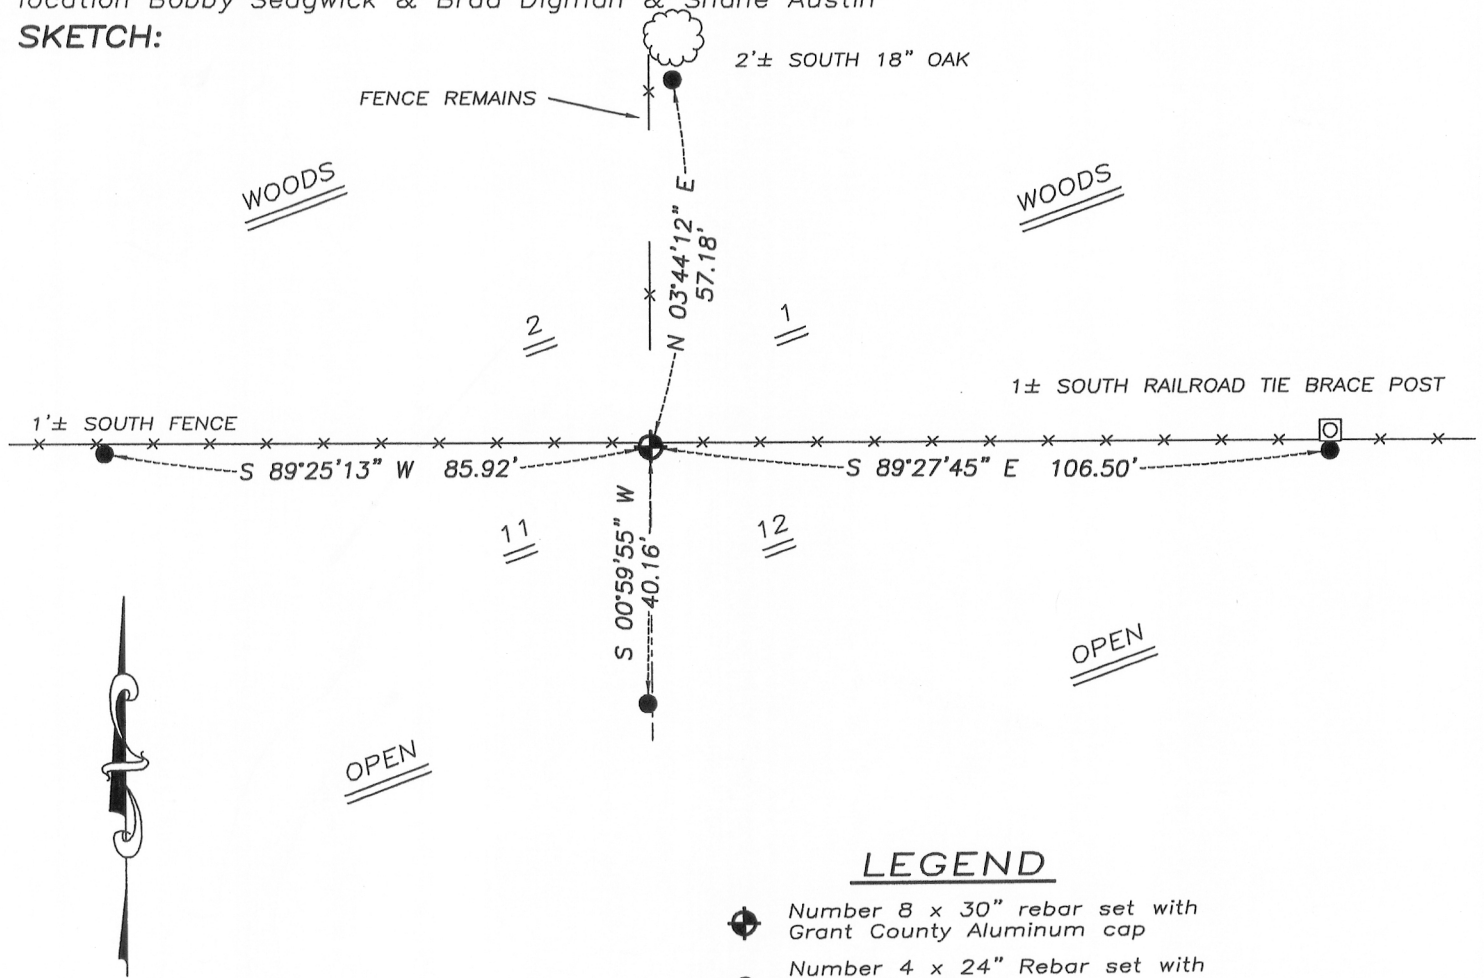

LEGEND

- Number 8 x 30" rebar set with Grant County Aluminum cap
- Number 4 x 24" Rebar set with red plastic "TIE" cap
- x- Approximate existing fence



Austin Engineering LLC
austinengineeringllc.com

4211 HWY 81 E, LANCASTER, WI 53813
PHONE: 608-723-6363 FAX: 608-723-6702

JOB NUMBER 10S039-MISSMTN
FIELDBOOK: TDSR, 1000
G:\T5NR6W\34
H:\TIE\T4NR6W\23

DRAWN BY: SW AUSTIN
APPROVED: LL AUSTIN

NOT TO SCALE