

U.S. PUBLIC LAND SURVEY MONUMENT RECORD - GRANT COUNTY, WI

Section 24, Town 4 North Range 6 West, Town of Glen Haven West


CERTIFICATE:

I, Chris D. Higgins, do hereby certify that the corner location on this record was determined by me and/or under my direct supervision and that this U.S. Public Land Survey Monument Record is correct and complete to the best of my knowledge and belief.

Dated this 31st day of October, 2012.

Chris D Higgins

Chris D. Higgins, RLS-2937-8

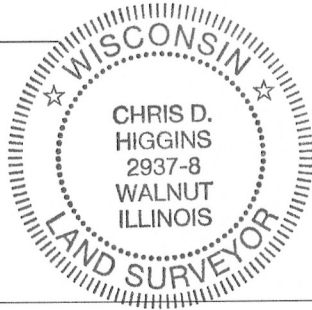

● = CORNER LOCATION

HISTORY OF CORNER ESTABLISHMENT:

No monumentation or recorded data was found for this corner.


DESCRIPTION OF CORNER EVIDENCE FOUND:

Corner set by proration from existing corners and occupation lines north, south, and west of corner. The location fits occupation.

DESCRIPTION OF CORNER AND WITNESS MONUMENTS, references and accessories used to perpetuate the original or re-established location of this corner. Witnesses to corner location Ben Scheffner and Rey Munoz

SKETCH:

⊗ = 3/4" x 36" Rebar Set

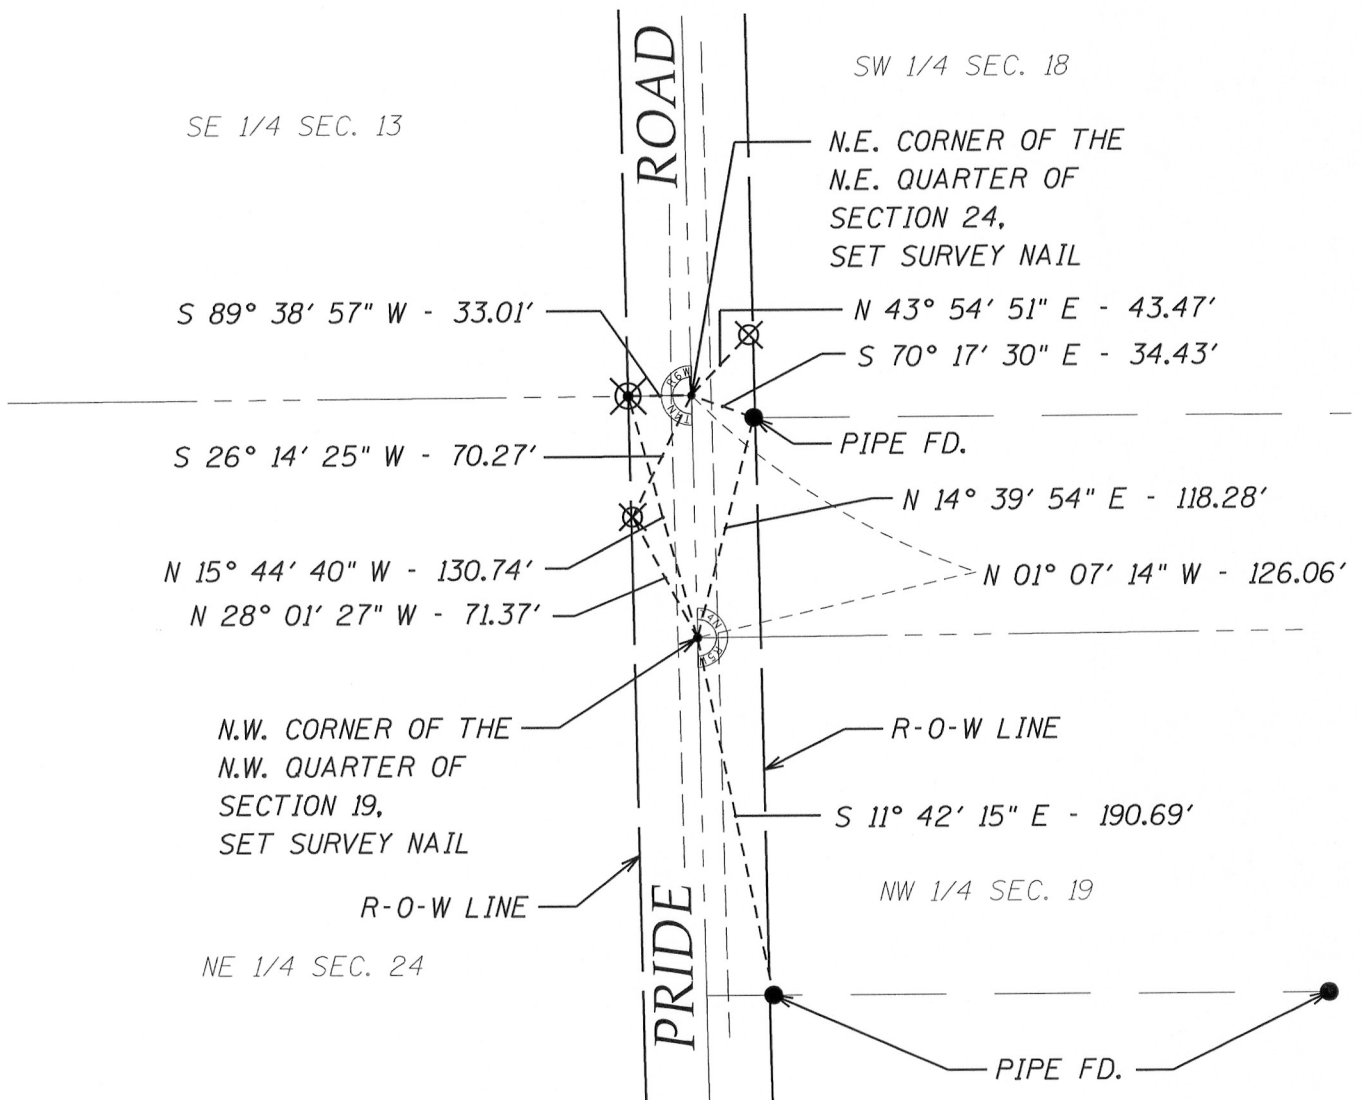

NOV 27 2012

61

Survey Monument Record

CORNER NO. _____
SECTION 18
TOWN 4N
RANGE 5W


JUL 11 1996
AUG 4 1996

TYPE OF MONUMENT NONE PLACED
STATE PLANE COORDINATES: N _____
E _____
ELEVATION — M.S.L. DATUM: _____
THETA ANGLE: _____
FIELD BOOK: _____
PAGE _____

BASIS FOR MONUMENT LOCATION

(Use reverse side if necessary)

Show info such as: History of corner, with reference to Vol. and pg., dates, surveyor; exact description of monument replaced; if location computed, by taped or EDM traverse; landowner, remarks, etc.

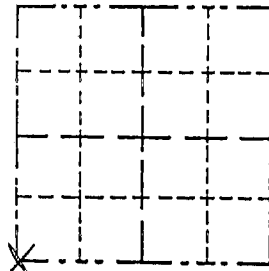

LOCATION
(Indicated by "X")


- FOUND PERPETUATED LOCATION
- OBLITERATED EVIDENCE LOCATION
- LOST CORNER (RESTORED BY PROPORTIONATE METHODS)

There are no recent survey records of this corner. The corner was computed at the proportional distance between monuments at the west 1/4 corner of 18-4-5W and the west 1/4 corner of 19-4-5W as per the diagram at left. It falls in the centerline ± of a N-S town road and fits the field line between sections 13 and 24 of 4N-6W.

CERTIFIED CORRECT TO THE BEST OF MY KNOWLEDGE AND BELIEF


Michael R. LaRosa
Registered Land Surveyor

DATE: 5/23/1996

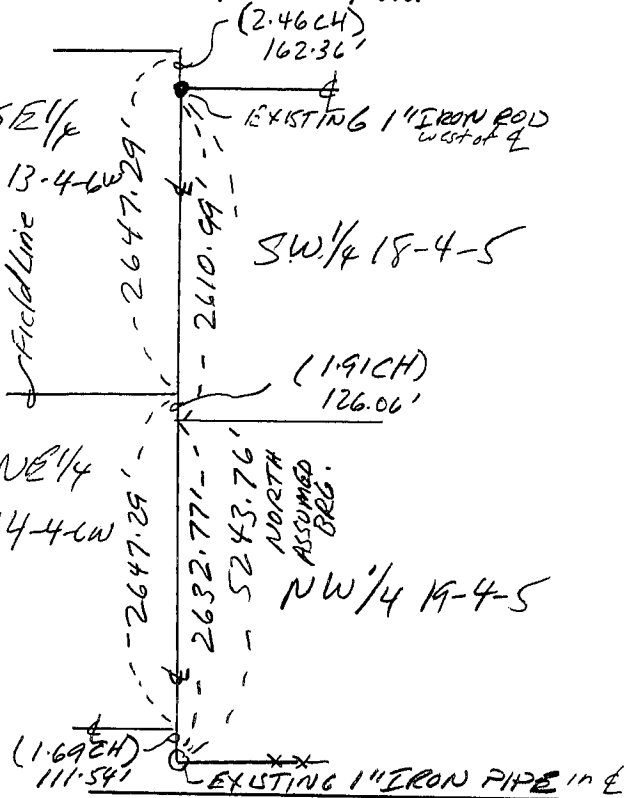

TIE SKETCH

Show at least (4) ties and monument

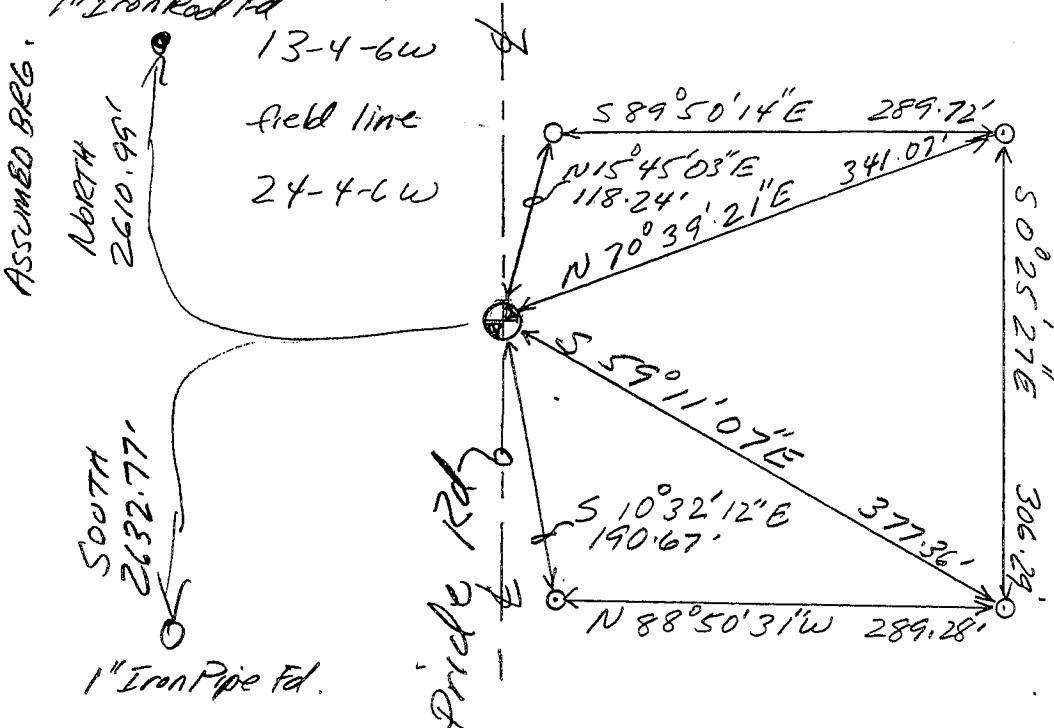

No scale

Legend

o 1" Iron Pipe Set

