


CERTIFIED LAND CORNER

STATE OF WISCONSIN)
 COUNTY OF GRANT) S.S.


CERTIFICATE

BRUCE D. BOWDEN certify
 that the corner location shown on this record was
 determined by me or under my direction and control
 and that this U.S. Public Land Survey Monument
 record is correct to the best of my knowledge and
 belief.

Bruce D. Bowden date 3-25-83

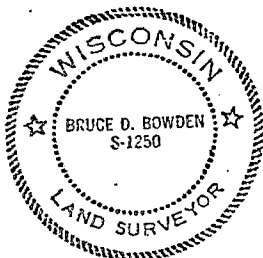

Seal

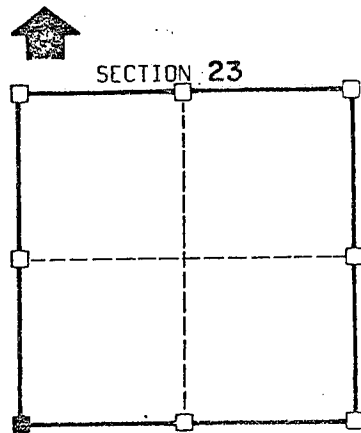

☐ = corner location

T 4 N R 6 W

Town of: GLEN HAVEN

History of original corner establishment:


Description of corner evidence found:
7" x 9" SETPOST AT CORNER

Description of corner and witness monuments, references and accessories used to
 perpetuate the original or re-established location of this corner:

Witnesses to corner location:

BRUCE BOWDEN REGISTERED LAND SURVEYOR
KEVIN ROPER

Sketch:

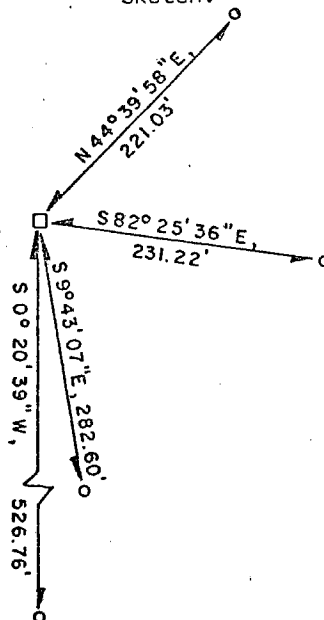

Legend

- ▽ SPIKE WITH WASHERS
- ☐ 7" X 9" SET POST
- No. 6 X 24" LONG REBAR

SURVEY CONTROL ORDER

Horizontal
Vertical

WISCONSIN COORDINATE SYSTEM

Corner	East (X)	North (Y)	Elevation (Z)	Zone
Control Sta. Name				

0-85 A