


CERTIFIED LAND CORNER

STATE OF WISCONSIN)
 COUNTY OF GRANT) S.S.


CERTIFICATE

I, BRUCE D. BOWDEN certify that the corner location shown on this record was determined by me or under my direction and control and that this U.S. Public Land Survey Monument Record is correct to the best of my knowledge and belief.

Bruce D. Bowden date 3-25-83

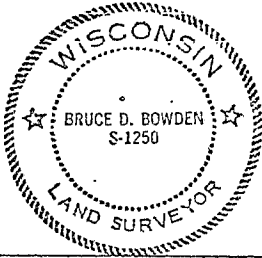

Seal

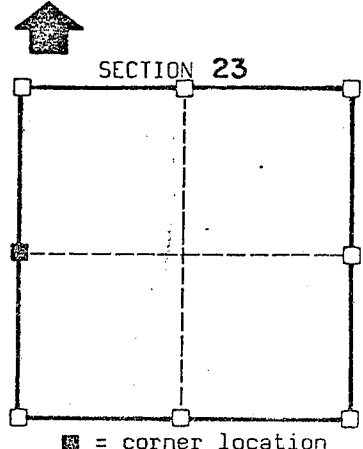

SECTION 23
 T 4 N R 6 W
 Town of: GLEN HAVEN

History of original corner establishment:

Description of corner evidence found:


E-W FENCE LINE & PROJECTION OF FENCE FROM SOUTH

Description of corner and witness monuments, references and accessories used to perpetuate the original or re-established location of this corner:

Witnesses to corner location:

BRUCE BOWDEN - REGISTERED LAND SURVEYOR
KEYVIN RÖDER

Sketch:

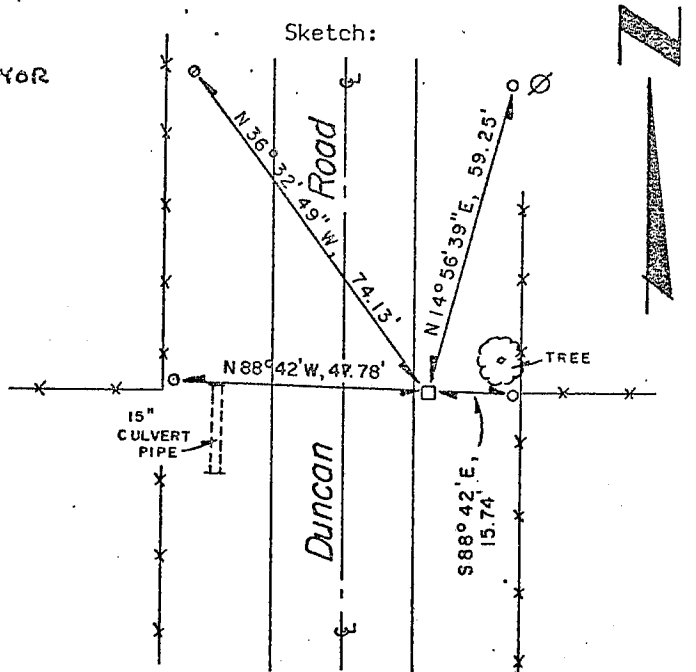

Legend

- ⊙ POWER POLE
- *-*- FENCELINE
- 1" Ø X 24" LONG SMOOTH ROD
- No. 6 X 24" LONG REBAR

SURVEY CONTROL ORDER

Horizontal	
Vertical	

WISCONSIN COORDINATE SYSTEM

Corner	East(X)	North(Y)	Elevation(Z)	Zone
Control Sta. Name				