


Survey Monument Record

TYPE OF MONUMENT Grant Co. Drivable Alum.
 STATE PLANE COORDINATES: N _____
 E _____
 ELEVATION — M.S.L. DATUM: _____
 THETA ANGLE: _____
 FIELD BOOK: 94-9
 PAGE 65

CORNER NO. _____
 SECTION 26 MAY 16 1995
 TOWN 4N
 RANGE 6W
 TOWN OF GLEN HAVEN

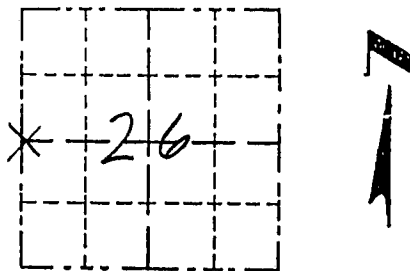

BASIS FOR MONUMENT LOCATION

(Use reverse side if necessary)

Show info such as: History of corner, with reference to Vol. and pg., dates, surveyor; exact description of monument replaced; if location computed, by taped or EDM traverse; landowner, remarks, etc.

LOCATION
 (Indicated by "X")
 A FOUND PERPETUATED LOCATION

SEAL:

The most recent Survey record noting this corner is a survey Dated 4/16/1855. Ownership records indicate that this corner has been "unoccupied" since the 1890's. The restored corner location was determined by a single line protraction between a stone of record at the SW corner and a post of record at the NW corner. The monument fell exactly at an old intersection of down and buried fences north and west of wire types dating from the turn of the century.



CERTIFIED CORRECT TO THE BEST OF MY KNOWLEDGE AND BELIEF

Michael R. Lofgren
 Registered Land Surveyor

DATE: 4/26/1995

TIE SKETCH

Show at least three (4) ties and monument

