


GREAT COUNTY
Survey Monument Record

TYPE OF MONUMENT 3/4" IRON ROD
 STATE PLANE COORDINATES: N _____
 E _____
 ELEVATION — M.S.L. DATUM: _____
 THETA ANGLE: _____
 FIELD BOOK: 95-2
 PAGE 10

CORNER NO. _____
 SECTION H/12 APR 24 1993
 TOWN 5
 RANGE 1W
per physical monument
Surveyed 3-8-95

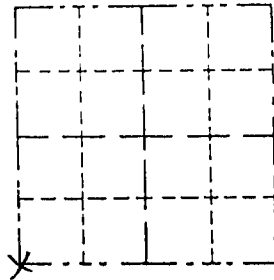

LOCATION
(Indicated by "X")


BASIS FOR MONUMENT LOCATION

(Use reverse side if necessary)

Show info such as: History of corner, with reference to Vol. and pg., dates, surveyor; exact description of monument replaced; if location computed, by taped or EDM traverse; landowner, remarks, etc.

SEAL:

THERE ARE NO RECENT RECORDS OF SURVEYS OR MONUMENTS FOR THIS CORNER. EXISTING PHYSICAL EVIDENCE IS THE INTERSECTION OF 2 TOWN ROADS. THE RESTORED CORNER LOCATION WAS BASED ON A DOUBLE PRORATE BETWEEN OCCUPIED CORNERS 1/2 MILE NORTH, 1 MILE SOUTH, 1/2 MILE WEST & AN EXISTING MONUMENT 1 MILE EAST.

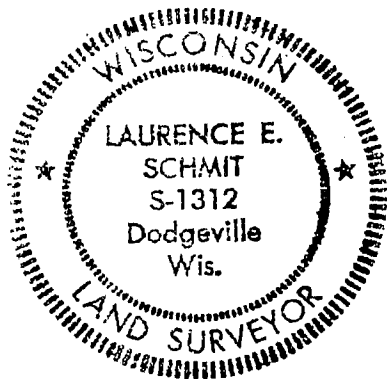

CERTIFIED CORRECT
Laurence E. Schmit
 Registered Land Surveyor
 DATE: 2-23-95

TIE SKETCH

Show at least three (4) ties and monument

LEGEND

- 1/2" IRON ROD
- RING SHANK NAIL
- FENCE

