


GRANT COUNTY

Survey Monument Record

GRANT Co.
TYPE OF MONUMENT ALUM. MONUMENT
STATE PLANE COORDINATES: N _____
E _____
ELEVATION — M.S.L. DATUM: _____
THETA ANGLE: _____
FIELD BOOK: 9321
PAGE _____

CORNER NO. 89
SECTION 29
TOWN 5 N
RANGE 1 W

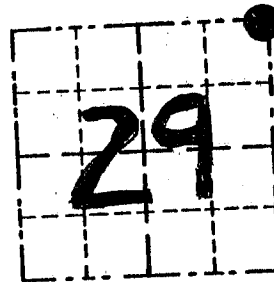

LOCATION
(Indicated by "●")

BASIS FOR MONUMENT LOCATION

(Use reverse side if necessary)

Show info such as: History of corner, with reference to Vol. and pg., dates, surveyor; exact description of monument replaced; if location computed, by taped or EDM traverse; landowner, remarks, etc.

SEAL:

NO RECORD FOUND OF COR.
SINCE ORIG. SURVEYS; N-S
LOCATION BASED ON OCCUPATION
& E-W. LOCATION DETERMINED
FROM PROPORTIONING TO NW COR SEC
29 & N 1/4 COR. OF SEC. 28.



CERTIFIED CORRECT

Larry L. Austin
Registered Land Surveyor

DATE: 1/5/94

TIE SKETCH

Show at least three (3) ties and monument

LEGEND

- ALUM. MON. SET = CORNER
- 3/8" x 12" STEEL SPIKES SET FLUSH = TIES

