


GRANT COUNTY

Survey Monument Record

GRANT Co.
TYPE OF MONUMENT ALUM. MONUMENT
STATE PLANE COORDINATES: N _____
E _____
ELEVATION — M.S.L. DATUM: _____
THETA ANGLE: _____
FIELD BOOK: 9321
PAGE _____

CORNER NO. _____
SECTION 29
TOWN 5N
RANGE 1W

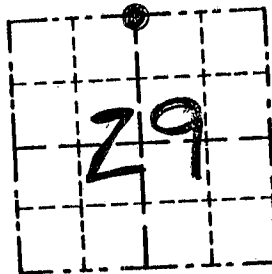

LOCATION
(Indicated by "•")


BASIS FOR MONUMENT LOCATION

(Use reverse side if necessary)

Show info such as: History of corner, with reference to Vol. and pg., dates, surveyor; exact description of monument replaced; if location computed, by taped or EDM traverse; landowner, remarks, etc.

NO RECORD FOUND SINCE ORIG SURVEY; CORNER SET ON OCCUPIED E-W FENCE - MIDWAY BETWEEN NE COR & NW COR. & VERIFIED BY EDM TRAVERSE OF THE AREA.

SEAL:

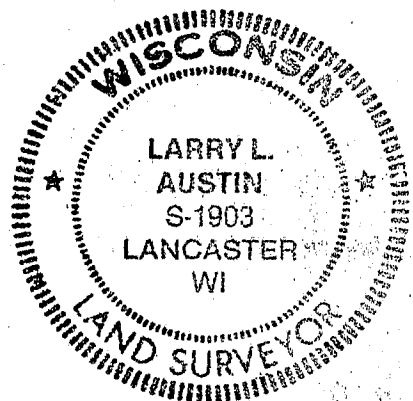


CERTIFIED CORRECT

Larry L. Austin
Registered Land Surveyor
DATE: 1/5/94

TIE SKETCH

Show at least three (3) ties and monument

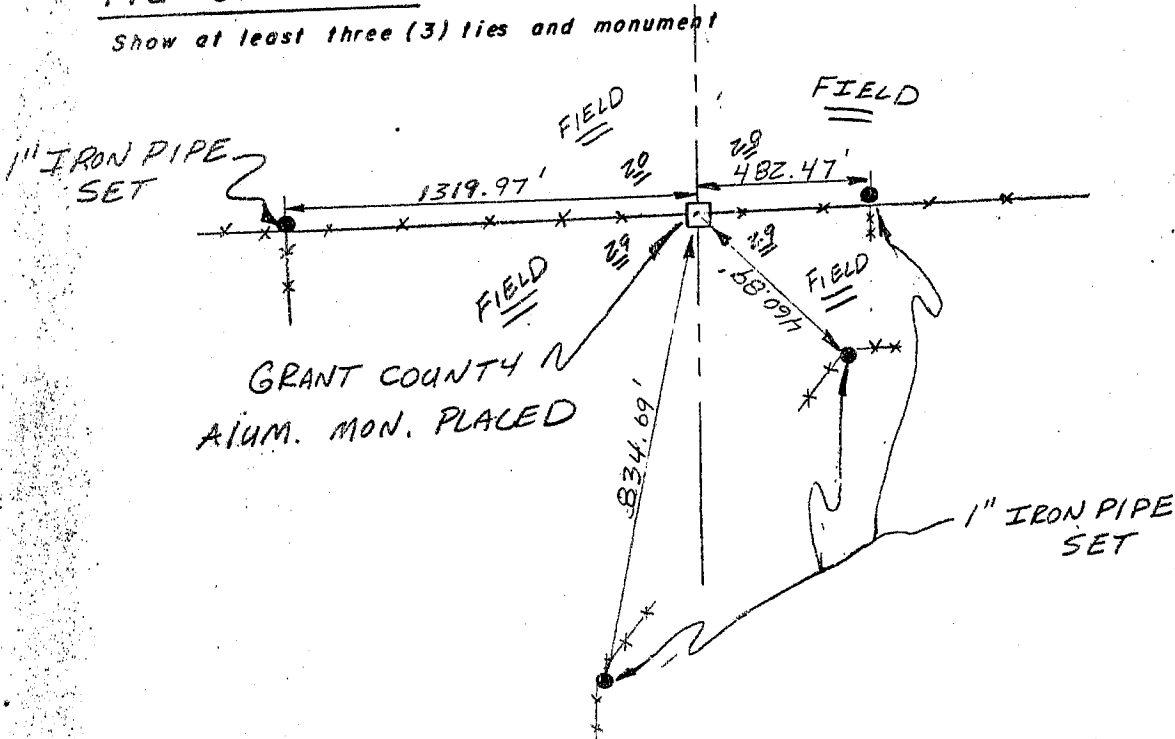

No SCALE