


# GRANT COUNTY

## Survey Monument Record

TYPE OF MONUMENT 3/4" IRON BAR SET  
 STATE PLANE COORDINATES: N \_\_\_\_\_  
 E \_\_\_\_\_  
 ELEVATION — M.S.L. DATUM: \_\_\_\_\_  
 THETA ANGLE: \_\_\_\_\_  
 FIELD BOOK: 9411  
 PAGE 23

CORNER NO. 83  
 SECTION 23  
 TOWN 5 N  
 RANGE 1 W

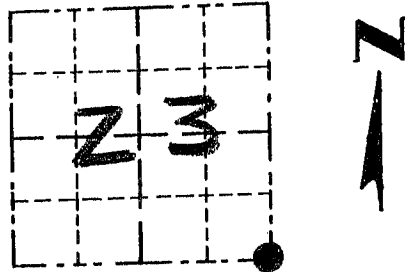


LOCATION  
 (Indicated by "•")

### BASIS FOR MONUMENT LOCATION

(Use reverse side if necessary)

Show info such as: History of corner, with reference to Vol. and pg., dates, surveyor; exact description of monument replaced; if location computed, by taped or EDM traverse; landowner, remarks, etc. **NO RECORD FOUND SINCE ORIGINAL SURVEYS; MONUMENT SET AT OCCUPIED & N-S & E-W; VERIFIED BY HWY PLANS & EDM TRAVERSE OF THE AREA.**

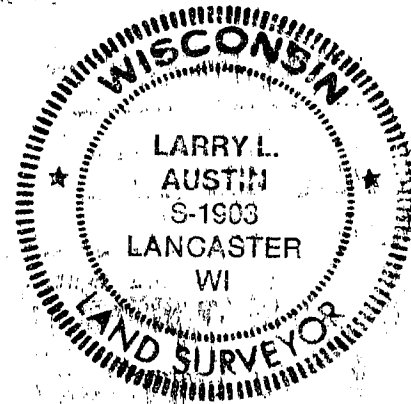

CERTIFIED CORRECT

*Larry L. Austin*  
 Registered Land Surveyor  
 DATE: 7/29/94

### TIE SKETCH

Show at least three (3) ties and monument

