

U.S. PUBLIC LAND SURVEY MONUMENT RECORD

(As Required By s. A-E 7.08, WI Adm. Code)

History of original corner establishment and subsequent restorations and description of any record, monument, occupational, testimonial or other evidence considered:

There are no recent records of this corner. A "new" and "contested" fence line was installed approximately 16' east of the corner to the north. Physical evidence is an E-W town road. The easting of the corner was computed at 1/2 the distance between the occupied SW corner and an Aluminum cap in a vault at the SE corner. The northing was computed based on relationships noted in a survey by J.C. Scott dated 3rd July 1885 & recorded in Book D on Page 158. See diagram below for details. This location is occupation to the west as well as the road.

Corner was: (Check All That Apply)

- Restored through acceptance of an obliterated evidence location
- Restored through acceptance of a found perpetuated location
- Considered a lost corner and reestablished through lost corner proportionate methods (include a plan view drawing showing distances and directions to other Public Land Survey Corners used for proportioning and determining the corner location)
- Restored or reestablished in a location that differs from a previous restoration or reestablishment (include a plan view drawing and indicate what was set and/or found)

Describe the monument and accessories used to perpetuate the location of this corner. (Include a plan view drawing and indicate what was set and/or found)

Found 1-1/4" IR @ NE 1/4 corner
 () recorded as (SCOTT SURVEY)
 * * * fence Fence corner @ NE corner of SE 1/4 - SW 1/4
 Nail set centerline of road and fence to south
 Found Alum Mon in vault SE corner

A-B 1305.03'
 B-C 1372.31'
 where B is E of rd at the west R/W PL of old Rd to north

5007'26"W
 1331'24" (20.22ch)
 5013'28"E 5331.74'

589°23'12"E 589°27'55"E
 2677.32' 2677.26'
 (40.665ch)

N 35°09'53"E 28.16'
 "CONTESTED" FENCE
 1/2" IR PIPE SET

NEW CALIFORNIA RD.


20-18 N 35°10'E 28.16' S 1/4 COR.
 20-21 N 19°19'E 43.44' SET 3/4" X 24" REBAR
 26-22 N 61°52'E 47.70'
 20-23 S 22°56'E 28.42'

LEGEND:
 ○ 1/2" REBAR TIE
 ● 5/8" REBAR TIE
 ⊕ POWER POLE

LAURENCE E. SCHMIT

LAURENCE E. SCHMIT
 S-1312
 Dodgeville
 Wis.

WISCONSIN LAND SURVEYOR

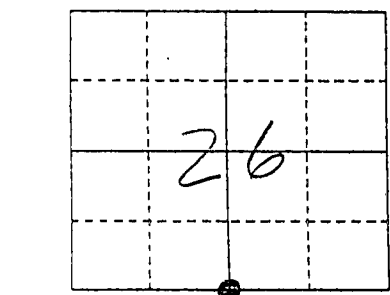

● = Location of Corner

I, LAURENCE E. SCHMIT
 Type or print name certify that the corner location shown on this record was determined by me or under my direction and control and that this U.S. Public Land Survey Monument Record is correct and complete to the best of my knowledge and belief.

Laurence E. Schmit 11/29/99
 Signature Date

Index No. 104