

GRANT COUNTY

Survey Monument Record

CORNER NO. 95
 SECTION 29
 TOWN 5 N
 RANGE 1 W

TYPE OF MONUMENT RAIL ROAD SPIKE


STATE PLANE COORDINATES: N _____
 E _____

ELEVATION — M.S.L. DATUM: _____

THETA ANGLE: _____

FIELD BOOK: 9321

PAGE _____

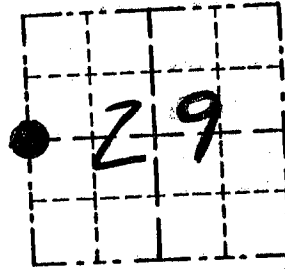

LOCATION
(Indicated by "●")


BASIS FOR MONUMENT LOCATION

(Use reverse side if necessary)

Show info such as: History of corner, with reference to Vol. and pg. dates, surveyor; exact description of monument replaced; if location computed, by taped or EDM traverse; landowner, remarks, etc.

SEAL:

NO RECORD FOUND OF CORNER SINCE ORIG. SURVEYS; N-S LOCATION BASED FENCE WEST & E-W LOCATION BASED ON 1/2 OF TWP. ROAD; VERIFIED BY EDM TRAVERSE OF THE AREA.

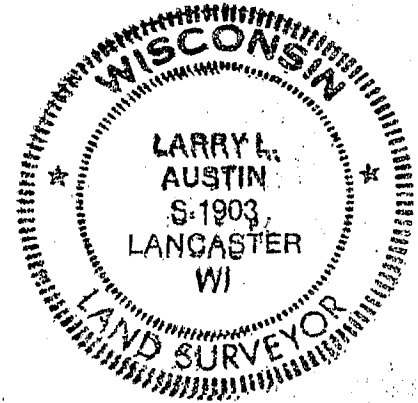

CERTIFIED CORRECT

Larry L. Austin
 Registered Land Surveyor

DATE: 1/5/94

TIE SKETCH

Show at least three (3) ties and monument

LEGEND

- RAIL ROAD SPIKE SET = CORNER
- 3/4" IRON BAR = TIES
- FENCE

